

Stone  
 G 2008  
 11/8/76

MISSISSIPPI  
 BOARD OF WATER COMMISSIONERS  
 416 North State Street  
 Jackson, Mississippi 39201

13a

WATER WELL DRILLERS LOG

11-8 1976 Arnold Anderson Stone  
 date well completed firm name county well located


LANDOWNER:	description of formations encountered	from	to
<u>Ivan Bond</u>	<u>Top Soil</u>	<u>0</u>	<u>3</u>
(mailing address)	<u>Red Clay</u>	<u>3</u>	<u>18</u>
WELL LOCATION:	<u>Fine Sand</u>	<u>18</u>	<u>34</u>
sec. <u>1</u> T. <u>3</u> N. R. <u>11</u> E. S. <u>W</u>	<u>Clay</u>	<u>34</u>	<u>40</u>
<u>7</u> miles <u>SE</u> of <u>Wiggins</u>	<u>Fine Sand</u>	<u>40</u>	<u>92</u>
(distance) (direction) of (nearest town)	<u>Coarse Sand</u>	<u>92</u>	<u>105</u>
WELL PURPOSE: <u>HOME</u> (home, irrigation, municipal, industrial)			
WELL COMPLETION DATA:			
(1) diameter (inches) <u>2"</u>			
(2) total depth (feet) <u>105'</u>			
(3) static water level (feet) <u>19'</u> below above top of ground.			
(4) casing <u>Plastic</u> , <u>100'</u> (material) (depth)			
(size) if telescope see back.			
(5) screen <u>5'</u> , <u>100'</u> (length) (depth to top)			
<u>2"</u> , <u>Plastic</u> (size) (material)			
(6) pump <u>1</u> , <u>10</u> (HP) (yield gpm)			
<u>Elect</u> (type power)			
(7) electric log <u>no</u> (yes or no)			
(organization running log)			
(8) how well bottom plugged <u>Capped</u>			
DRILLERS REMARKS:			

RECEIVED  
 DEC 10 1976

OF WATER COMMISSIONERS

If well telescopes please sketch and show depths.

GROUND LEVEL

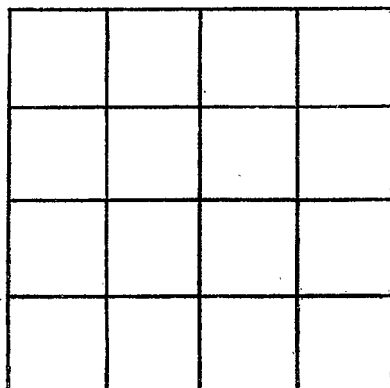

SECTION \_\_\_\_\_

Please indicate well location X.

ADDITIONAL INFORMATION

If more than one screen, show locations of each on sketch.