

Stone
 G 2007
 9/29/76

MISSISSIPPI
 BOARD OF WATER COMMISSIONERS
 416 North State Street
 Jackson, Mississippi 39201

WATER WELL DRILLERS LOG

9-29 1976 *Pernell Anderson Stone*
 date well completed firm name county well located


| LANDOWNER: | description of formations encountered | from | to |
|---|---------------------------------------|----------|-----------|
| <i>B. Kornschie</i> | <i>Top Soil</i> | <i>6</i> | <i>2</i> |
| (mailing address) | <i>Coarse Sand</i> | <i>2</i> | <i>65</i> |
| WELL LOCATION: | | | |
| sec. <i>6</i> T. <i>3</i> S. R. <i>11</i> W. <i>3</i> miles <i>S</i> of <i>Weyler</i> (distance) (direction) (nearest town) | | | |
| WELL PURPOSE: <i>HOME</i> (home, irrigation, municipal, industrial) | | | |
| WELL COMPLETION DATA: | | | |
| (1) diameter (inches) <i>2"</i> | | | |
| (2) total depth (feet) <i>65'</i> | | | |
| (3) static water level (feet) <i>20'</i> ^{below} above top of ground. | | | |
| (4) casing (material) <i>Plastic</i> , (depth) <i>60'</i> | | | |
| (size) If telescope see back. | | | |
| (5) screen (length) <i>5'</i> , (depth to top) <i>60'</i> | | | |
| (size) <i>2"</i> , (material) <i>Plastic</i> | | | |
| (6) pump (HP) <i>1</i> , (yield gpm) <i>15'</i> | | | |
| (type power) <i>Elect</i> | | | |
| (7) electric log <i>No</i> (yes or no) | | | |
| (organization running log) | | | |
| (8) how well bottom plugged <i>Plugged</i> | | | |
| DRILLERS REMARKS: | | | |

RECEIVED
 OCT - 8 1976

MISS. BD. OF WATER COMM.

If well telescopes please sketch and show depths.

GROUND LEVEL

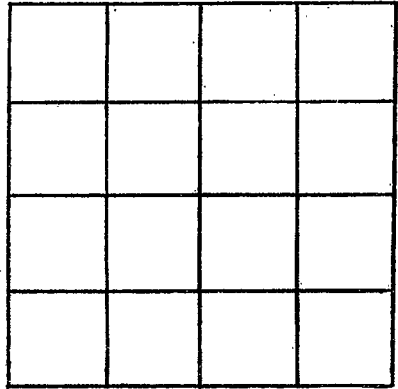

SECTION _____

Please indicate well location X.

ADDITIONAL INFORMATION

If more than one screen, show locations of each on sketch.