

Stone
G 2010
11-9-76

MISSISSIPPI
 BOARD OF WATER COMMISSIONERS
 416 North State Street
 Jackson, Mississippi 39201

WATER WELL DRILLERS LOG

11-9 1976 Parnell Anderson Stone
 date well completed firm name county well located

LANDOWNER: Andy Lott
 (mailing address)

description of formations encountered	from	to
<u>Top Soil</u>	<u>0</u>	<u>2</u>
<u>Sandy Clay</u>	<u>2</u>	<u>23</u>
<u>Thin Sand</u>	<u>23</u>	<u>74</u>

WELL LOCATION:
 sec 9 T 3 S R 11 E W
4 miles SE of Wiggins
 (distance) (direction) (nearest town)

WELL PURPOSE: HOME
 (home, irrigation, municipal, industrial)


- WELL COMPLETION DATA:
- (1) diameter (inches) 2"
 - (2) total depth (feet) 74'
 - (3) static water level (feet) 31' below above top of ground.
 - (4) casing Plastic, 69'
 (material) (depth)
 (size) if telescope see back.
 - (5) screen 5", 69'
 (length) (depth to top)
2", Plastic
 (size) (material)
 - (6) pump 1 10
 (HP) (yield gpm)
Electric
 (type power)
 - (7) electric log no
 (yes or no)
- (organization running log)
- (8) how well bottom plugged closed

DRILLERS REMARKS:

RECEIVED
 DEC 10 1976

If well telescopes please sketch and show depths.

GROUND LEVEL

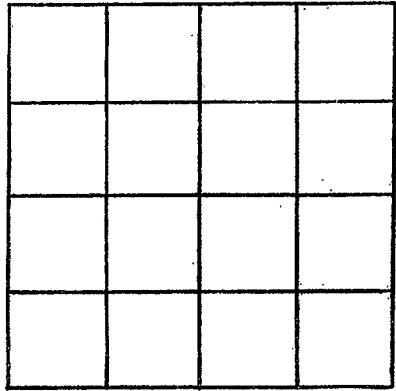

SECTION _____

Please indicate well location X.

ADDITIONAL INFORMATION

If more than one screen, show locations of each on sketch.