

Stone  
G 2011  
12/23/76

MISSISSIPPI  
BOARD OF WATER COMMISSIONERS  
416 North State Street  
Jackson, Mississippi 39201

WATER WELL DRILLERS LOG

12-23  
date well completed

1976

Pernell Anderson Stone  
firm name

county well located

LANDOWNER:

David Walker

description of formations  
encountered

Top Soil

from

to

0

2

Red Clay

2

8

(mailing address)

7 Sand

8

63

WELL LOCATION:

sec. 9 T. 3 S. R. 11 E. W. 4 miles SE of Wagon (distance) (direction) (nearest town)

Coarse Sand

63

93

WELL PURPOSE: HOME (home, irrigation, municipal, industrial)

WELL COMPLETION DATA:

- (1) diameter (inches) 2 1/2  
(2) total depth (feet) 93  
(3) static water level (feet) 37' below top of ground  
(4) casing Plastic 88' (material) (depth)

(size) If telescope see back.

- (5) screen 5' 88' (length) (depth to top)  
2" Plastic (size) (material)

- (6) pump 1 11 (HP) (yield gpm)  
Elect (type power)

- (7) electric log no (yes or no)

(organization running log)

- (8) how well bottom plugged Capped

DRILLERS REMARKS:


RECEIVED

JAN 5 1977

MISS. BD. OF WATER COMM.

If well telescopes please  
sketch and show depths.

GROUND LEVEL

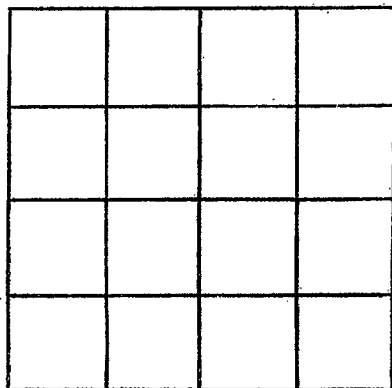

SECTION \_\_\_\_\_

Please indicate well location X.

ADDITIONAL INFORMATION

If more than one screen,  
show locations of each on sketch.