

Stone  
 G 2012  
 1-23-77

MISSISSIPPI  
 BOARD OF WATER COMMISSIONERS  
 416 North State Street  
 132 Jackson, Mississippi 39201

④

WATER WELL DRILLERS LOG

Jan 23 1977 Reeves Well Co Stone  
 date well completed firm name county well located

LANDOWNER:  
Mr. John H. Freeman  
Rt 1, Wiggins 39577  
 (mailing address)

description of formations encountered	from	to
<u>sandy clay</u>	<u>0</u>	<u>22</u>
<u>consolid sand</u>	<u>22</u>	<u>84</u>

WELL LOCATION:  
 sec 6 T 3 R 11 E  
2 miles South of Wiggins  
 (distance) (direction) (nearest town)

WELL PURPOSE: Truck  
 (home, irrigation, municipal, industrial)

WELL COMPLETION DATA:  
 (1) diameter (inches) 4"  
 (2) total depth (feet) 84  
 (3) static water level (feet) 35 below above top of ground.  
 (4) casing Plastic 10 ft bottom  
 (material) (depth)  
 (size) If telescope see back.  
 (5) screen 5' 79'  
 (length) (depth to top)  
1/2" Plastic  
 (size) (material)  
 (6) pump 1/2 10  
 (HP) (yield gpm)  
Electric  
 (type power)  
 (7) electric log no  
 (yes or no)  
 (organization running log)

(8) how well bottom plugged  
wooden plug


DRILLERS REMARKS:

RECEIVED  
 FEB 18 1977

MISS. BD. OF WATER COMMISSIONERS

If well telescopes please sketch and show depths.

GROUND LEVEL

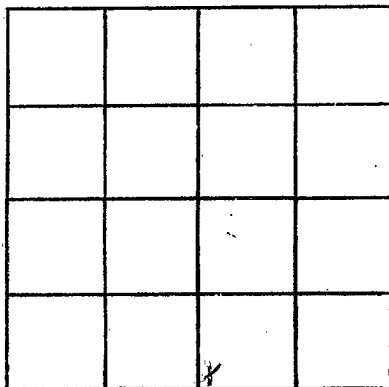

SECTION 6

Please indicate well location X.

ADDITIONAL INFORMATION

If more than one screen,  
show locations of each on sketch.