

Stone  
G 203  
1-24-77

MISSISSIPPI  
 BOARD OF WATER COMMISSIONERS  
 416 North State Street  
 Jackson, Mississippi 39201

(5)

WATER WELL DRILLERS LOG

Jan 24 19 77 Recess Well Co Stone  
 date well completed firm name county well located

LANDOWNER:  
David Edwards  
Rt 1. box 58B Wiggins  
 (mailing address)

description of formations encountered	from	to
<u>Sand clay</u>	<u>0</u>	<u>10</u>
<u>Coarse sand</u>	<u>10</u>	<u>65</u>

WELL LOCATION:  
 sec. 6 T. 3 R. 11  
2 miles South of Wiggins  
 (distance) (direction) (nearest town)

WELL PURPOSE: Tracked  
 (home, irrigation, municipal, industrial)

WELL COMPLETION DATA:

(1) diameter (inches) 4"

(2) total depth (feet) 65

(3) static water level (feet) 20 below top of ground.

(4) casing Plastic (material) 10' to bottom (depth)

(size) If telescope see back.

(5) screen 6' (length) 59' (depth to top)

4" (size) Plastic (material)

(6) pump 1/2 hp (HP) 10 (yield gpm)

elect (type power)

(7) electric log no (yes or no)

(organization running log)

(8) how well bottom plugged  
Wiggins pump


DRILLERS REMARKS:

RECEIVED  
 FEB 18 1977

MISS. BLD. OF WATER COMMISSIONERS

If well telescopes please  
sketch and show depths.

GROUND LEVEL

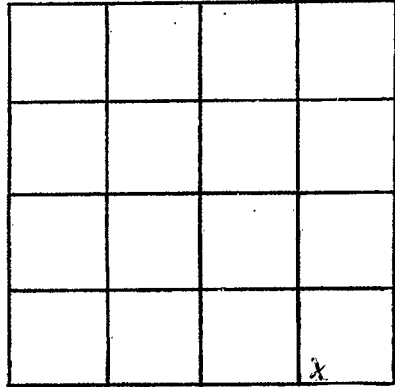

SECTION 6

Please indicate well location X.

ADDITIONAL INFORMATION

If more than one screen,  
show locations of each on sketch.