

Stone
 G 2014
 6-27

MISSISSIPPI
 BOARD OF WATER COMMISSIONERS
 416 North State Street
 132 Jackson, Mississippi 39201

WATER WELL DRILLERS LOG

6-19 77 Perrell Anderson Stone
 date well completed firm name county well located

LANDOWNER:	description of formations encountered	from	to
<u>Bill Ishee</u>			
(mailing address)	<u>Clay</u>	<u>3</u>	<u>17</u>
WELL LOCATION:	<u>Fill Sand</u>	<u>17</u>	<u>73</u>
sec. <u>6</u> T. <u>3</u> R. <u>11</u>	<u>Course Sand</u>	<u>73</u>	<u>85</u>
<u>0 1/2</u> miles <u>S</u> of <u>Wiggins</u>			
(distance) (direction) (nearest town)			
WELL PURPOSE: <u>HOME</u> (home, irrigation, municipal, industrial)			
WELL COMPLETION DATA:			
(1) diameter (inches) <u>2"</u>			
(2) total depth (feet) <u>85'</u>			
(3) static water level (feet) <u>21'</u> below above top of ground.			
(4) casing <u>Plastic</u> , <u>80'</u> (material) (depth)			
(size) If telescope see back.			
(5) screen <u>5'</u> , <u>80'</u> (length) (depth to top)			
<u>2"</u> , <u>Plastic</u> (size) (material)			
(6) pump <u>1</u> , <u>18</u> (HP) (yield gpm)			
<u>Elect</u> (type power)			
(7) electric log <u>no</u> (yes or no)			
(organization running log)			
(8) how well bottom plugged <u>capped</u>			

RECEIVED


JUL 5 1977

DRILLERS REMARKS:

MISS. Bd. OF WATER COMM.

If well telescopes please sketch and show depths.

GROUND LEVEL

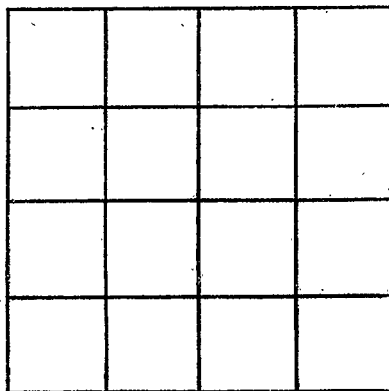

SECTION _____

Please indicate well location X.

ADDITIONAL INFORMATION

If more than one screen, show locations of each on sketch.