

Stone
G 2015
6-6-77

MISSISSIPPI
BOARD OF WATER COMMISSIONERS
416 North State Street
132 Jackson, Mississippi 39201

WATER WELL DRILLERS LOG

6-6 1977 Panel Anderson Stone
date well completed firm name county well located


LANDOWNER:	description of formations encountered	from	to
<u>Ray Sumrall</u>	<u>Top Soil</u>	<u>0</u>	<u>3</u>
<u>Ray Sumrall Jr.</u>	<u>Red Sand</u>	<u>3</u>	<u>22</u>
(mailing address)	<u>Coarse Sand</u>	<u>22</u>	<u>65</u>
WELL LOCATION:			
sec <u>5</u> T <u>3</u> R <u>11</u> S <u>W</u>			
<u>2 1/2</u> miles <u>SE</u> of <u>Wiggins</u>			
(distance) (direction) (nearest town)			
WELL PURPOSE: <u>HOME</u>			
(home, irrigation, municipal, industrial)			
WELL COMPLETION DATA:			
(1) diameter (inches) <u>2"</u>			
(2) total depth (feet) <u>65'</u>			
(3) static water level (feet) <u>10'</u> below top of ground.			
(4) casing <u>Plastic</u> , <u>60'</u>			
(material) (depth)			
(size) If telescope see back.			
(5) screen <u>5'</u> , <u>60'</u>			
(length) (depth to top)			
<u>2"</u> , <u>Plastic</u>			
(size) (material)			
(6) pump <u>1</u> , <u>1.2</u>			
(HP) (yield gpm)			
<u>Elect</u>			
(type power)			
(7) electric log <u>NO</u>			
(yes or no)			
(organization running log)			
(8) how well bottom plugged <u>Capped</u>			
DRILLERS REMARKS:			

RECEIVED
JUL 5 - 1977

MISS. BD. OF WATER COMMISSIONERS

If well telescopes please
sketch and show depths.

GROUND LEVEL

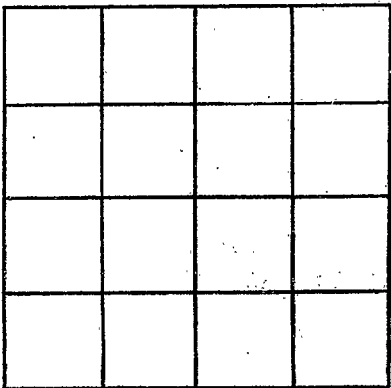

SECTION _____

Please indicate well location X.

ADDITIONAL INFORMATION

If more than one screen,
show locations of each on sketch.