

Stone
 G 2016
 8-25-77

MISSISSIPPI
 BOARD OF WATER COMMISSIONERS
 416 North State Street
 132 Jackson, Mississippi 39201

WATER WELL DRILLERS LOG

8-25-1977 date well completed
 132 firm name
 Stone county well located

LANDOWNER: Joe Copfield
 description of formations encountered: Top Soil from 8 to 18
 Red Clay 18 to 39
 coarse sand 39 to 105
 (mailing address)

WELL LOCATION:
 sec. 2 T 30 R 11 E S W
 5 miles SE of Wiggins
 (distance) (direction) (nearest town)

WELL PURPOSE: HOME
 (home, irrigation, municipal, industrial)


- WELL COMPLETION DATA:
- (1) diameter (inches) 2"
 - (2) total depth (feet) 105'
 - (3) static water level (feet) 47' below top of ground
 - (4) casing (material) Plastic 100' (depth)
 - (size) If telescope see back.
 - (5) screen (length) 5' (depth to top) 100'
 - (size) (material) 2" Plastic
 - (6) pump (HP) 1 (yield gpm) 11
 - (type power) E. Lee
 - (7) electric log (yes or no) NA
 - (organization running log)
 - (8) how well bottom plugged: capped

DRILLERS REMARKS:

RECEIVED
 SEP - 2 1977
 MISS. BD. OF WATER COMMISSIONERS

If well telescopes please sketch and show depths.

GROUND LEVEL

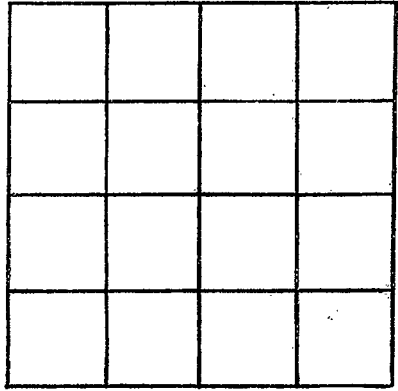

SECTION _____

Please indicate well location X.

ADDITIONAL INFORMATION

If more than one screen, show locations of each on sketch.