

Stone
 2018
 9/28/77

MISSISSIPPI
 BOARD OF WATER COMMISSIONERS
 416 North State Street
 Jackson, Mississippi 39201

WATER WELL DRILLERS LOG

9-28 19 Stone firm name Stone county well located

LANDOWNER:	description of formations encountered	from	to
<u>Elmer Alexander</u>	<u>Top Soil</u>	<u>0</u>	<u>3</u>
(mailing address)	<u>Red Clay</u>	<u>3</u>	<u>17</u>
WELL LOCATION:	<u>Fine Sand</u>	<u>17</u>	<u>88</u>
sec <u>6</u> T <u>3</u> N <u>11</u> E	<u>Blue Clay</u>	<u>88</u>	<u>177</u>
<u>2</u> miles <u>S</u> of <u>Wright</u>	<u>Fine Sand</u>	<u>177</u>	<u>232</u>
(distance) (direction) (nearest town)	<u>Coarse Sand</u>	<u>232</u>	<u>250</u>
WELL PURPOSE: <u>HOME</u>			
(home, irrigation, municipal, industrial)			

WELL COMPLETION DATA:

(1) diameter (inches) 2"

(2) total depth (feet) 250'

(3) static water level (feet) 70' below above top of ground.

(4) casing Plastic, 245' (material) (depth)

(size) If telescope see back.

(5) screen 5", 245' (length) (depth to top)

2", Plastic (size) (material)

(6) pump 1 (HP) 6 (yield gpm)

Elect. (type power)

(7) electric log no (yes or no)

(organization running log)

(8) how well bottom plugged Back wash valve


RECEIVED

NOV - 8 1977

DRILLERS REMARKS:

If well telescopes please sketch and show depths.

GROUND LEVEL

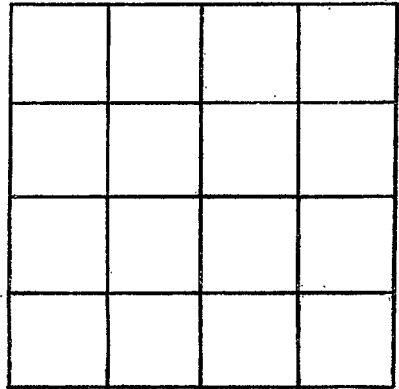

SECTION _____

Please indicate well location X.

ADDITIONAL INFORMATION

If more than one screen, show locations of each on sketch.