

Stone
 B209
 10/2/77

MISSISSIPPI
 BOARD OF WATER COMMISSIONERS
 416 North State Street
 Jackson, Mississippi 39201

WATER WELL DRILLERS LOG


10-2 1977 Samuel Anderson Stone
 date well completed firm name county well located

LANDOWNER:	description of formations encountered	from	to
<u>Donnie Parker</u>	<u>Top Soil</u>	<u>0</u>	<u>2</u>
(mailing address)	<u>Red Clay</u>	<u>2</u>	<u>15</u>
WELL LOCATION: sec. <u>10</u> T. <u>3</u> S. R. <u>11</u> W. <u>5</u> miles <u>SW</u> of <u>Wagon</u> (distance) (direction) (nearest town)	<u>Course Sand</u>	<u>15</u>	<u>80</u>
WELL PURPOSE: <u>HOME</u> (home, irrigation, municipal, industrial)			
WELL COMPLETION DATA: (1) diameter (inches) <u>2"</u> (2) total depth (feet) <u>80</u> (3) static water level (feet) <u>44'</u> below above top of ground. (4) casing <u>Plastic 75'</u> (material) (depth) (size) if telescope see back. (5) screen <u>5'</u> <u>75'</u> (length) (depth to top) <u>2"</u> <u>Plastic</u> (size) (material) (6) pump <u>1</u> <u>7</u> (HP) (yield gpm) <u>Elect</u> (type power) (7) electric log <u>no</u> (yes or no) (organization running log) (8) how well bottom plugged <u>cased</u>			
DRILLERS REMARKS:			

RECEIVED
 NOV - 8 1977
 MISSISSIPPI BOARD OF WATER COMMISSIONERS

If well telescopes please sketch and show depths.

GROUND LEVEL

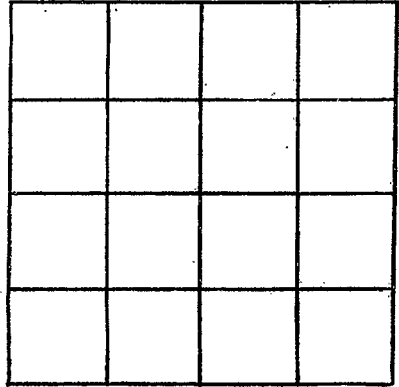

SECTION _____

Please indicate well location X.

ADDITIONAL INFORMATION

If more than one screen, show locations of each on sketch.