

Stone  
 15000  
 10/3/77

MISSISSIPPI  
 BOARD OF WATER COMMISSIONERS  
 416 North State Street  
 Jackson, Mississippi 39201

WATER WELL DRILLERS LOG


10-3 1977 Stone firm name Stone county well located

LANDOWNER:	description of formations encountered	from	to
<u>Haslee Penning</u> (mailing address)	<u>Top Soil</u>	<u>0</u>	<u>5</u>
	<u>Sandy clay</u>	<u>5</u>	<u>31</u>
WELL LOCATION: sec. <u>12</u> T <u>3</u> N R <u>2</u> W <u>6</u> miles <u>S</u> <u>NE</u> of <u>Wedge</u> (distance) (direction) (nearest town)	<u>Coarse Sand</u>	<u>31</u>	<u>85</u>
WELL PURPOSE: <u>HOME</u> (home, irrigation, municipal, industrial)			
WELL COMPLETION DATA:			
(1) diameter (inches) <u>2"</u>			
(2) total depth (feet) <u>85'</u>			
(3) static water level (feet) <u>20'</u> below top of ground.			
(4) casing <u>Plastic</u> <u>80'</u> (material) (depth)			
(size) If telescope see back.			
(5) screen <u>5'</u> <u>80'</u> (length) (depth to top)			
(size) <u>2"</u> <u>Plastic</u> (material)			
(6) pump <u>1</u> <u>12</u> (HP) (yield gpm)			
<u>Electric</u> (type power)			
(7) electric log <u>NO</u> (yes or no)			
(organization running log)			
(8) how well bottom plugged <u>Capped</u>			
DRILLERS REMARKS:			

RECEIVED  
 NOV - 8 1977

If well telescopes please sketch and show depths.

GROUND LEVEL

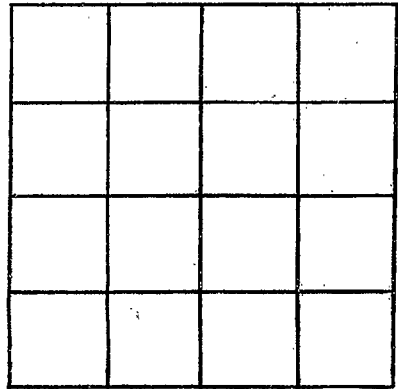

SECTION \_\_\_\_\_

Please indicate well location X.

ADDITIONAL INFORMATION

If more than one screen, show locations of each on sketch.