

Stone
 62021
 10/5/77

MISSISSIPPI
 BOARD OF WATER COMMISSIONERS
 416 North State Street
 Jackson, Mississippi 39201

WATER WELL DRILLERS LOG

10-5-77 1977 Pennell Anderson Stone
 date well completed firm name county well located

LANDOWNER:
Elton Littlefield
 (mailing address)

description of formations encountered	from	to
Top Soil	0	3
Pink clay	3	8
Flint Sand	8	29
Red Clay	29	88
Course Sand	88	125

WELL LOCATION:
 sec. 2 T 3 N R 11 E
 S W
6 miles SE of Wiggins
 (distance) (direction) (nearest town)

WELL PURPOSE: HOME
 (home, irrigation, municipal, industrial)

WELL COMPLETION DATA:

(1) diameter (inches) 2"

(2) total depth (feet) 125'

(3) static water level (feet) 42' below above top of ground.

(4) casing Plastic, 120'
 (material) (depth)
 (size) if telescope see back.

(5) screen 5" 120'
 (length) (depth to top)
2" Plastic
 (size) (material)

(6) pump 1 (HP) 10 (yield gpm)
Eled
 (type power)

(7) electric log no
 (yes or no)

(organization running log)


(8) how well bottom plugged capped

DRILLERS REMARKS:

RECEIVED
 NOV - 8 1977

If well telescopes please sketch and show depths.

GROUND LEVEL

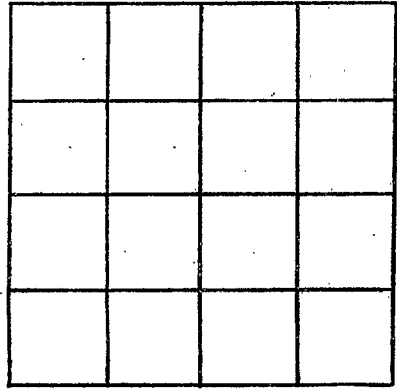

SECTION _____

Please indicate well location X.

ADDITIONAL INFORMATION

If more than one screen, show locations of each on sketch.