

Stone
 52022
 10/19/77

MISSISSIPPI
 BOARD OF WATER COMMISSIONERS
 416 North State Street
 Jackson, Mississippi 39201

WATER WELL DRILLERS LOG

10-19-77 date well completed
 Stone firm name
 Stone county well located

LANDOWNER:
 Leroy Yeager
 (mailing address)

WELL LOCATION:
 sec 30 T 9 S R 11 W
 3 miles (distance) of Park (direction) of (nearest town)

WELL PURPOSE: HOME
 (home, irrigation, municipal, industrial)

- WELL COMPLETION DATA:
- (1) diameter (inches) 2"
 - (2) total depth (feet) 210'
 - (3) static water level (feet) 45' below top of ground.
 - (4) casing Plastic, 205' (material) (depth)
 - (size) If telescope see back.
 - (5) screen 5' 205' (length) (depth to top)
 - (size) Plastic (material)
 - (6) pump 1 (HP) 10 (yield gpm)
 - Elect (type power)
 - (7) electric log no (yes or no)
 - (organization running log)
 - (8) how well bottom plugged Back wash Valve


description of formations encountered	from	to
Top Soil	0	2
White Clay	2	49
Blue Clay	44	130
Full Sand	130	195
Course Sand	195	210

DRILLERS REMARKS:

RECEIVED
 NOV - 8 1977

If well telescopes please sketch and show depths.

GROUND LEVEL

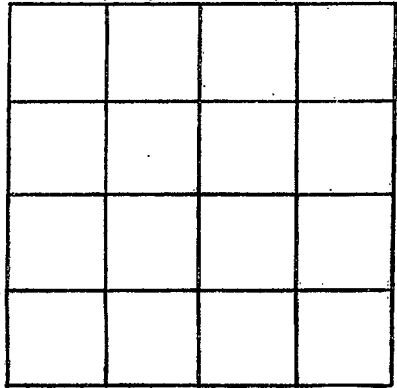

SECTION _____

Please indicate well location X.

ADDITIONAL INFORMATION

If more than one screen, show locations of each on sketch.