

Stone
 52023
 12/1/77

MISSISSIPPI
 BOARD OF WATER COMMISSIONERS
 416 North State Street
 Jackson, Mississippi 39201


WATER WELL DRILLERS LOG

12-1 1977 Parnell Anderson Stone
 date well completed firm name county well located

LANDOWNER:	description of formations encountered	from	to
<u>Wadrow Preston</u> (mailing address)	<u>Top Soil</u>	<u>0</u>	<u>3</u>
WELL LOCATION: sec. <u>13</u> T <u>3</u> S R. <u>11</u> W <u>7 1/2</u> miles <u>SE</u> of <u>Weggle</u> (distance) (direction) (nearest town)	<u>Red Sandy Clay</u>	<u>3</u>	<u>33</u>
WELL PURPOSE: <u>HOME</u> (home, irrigation, municipal, industrial)	<u>Coarse Sand</u>	<u>33</u>	<u>85</u>
WELL COMPLETION DATA: (1) diameter (inches) <u>2"</u> (2) total depth (feet) <u>85'</u> (3) static water level (feet) <u>31'</u> below above top of ground. (4) casing <u>Plastic</u> , <u>80'</u> (material) (depth) (size) If telescope see back. (5) screen <u>5'</u> <u>80'</u> (length) (depth to top) <u>2"</u> <u>Plastic</u> (size) (material) (6) pump <u>1</u> <u>10</u> (HP) (yield gpm) <u>Elect</u> (type power) (7) electric log <u>no</u> (yes or no) (organization running log) (8) how well bottom plugged <u>Cap</u>	<p>RECEIVED JAN 4 1978 MISSISSIPPI BOARD OF WATER COMMISSIONERS</p>	DRILLERS REMARKS:	

If well telescopes please sketch and show depths.

GROUND LEVEL

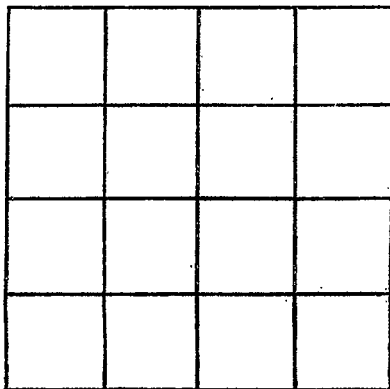

SECTION _____

Please indicate well location X.

ADDITIONAL INFORMATION

If more than one screen, show locations of each on sketch.