

Stone  
 10 2024  
 12/2/77

MISSISSIPPI  
 BOARD OF WATER COMMISSIONERS  
 416 North State Street  
 Jackson, Mississippi 39201

WATER WELL DRILLERS LOG

12-2 1977 *Parrell* Stone  
 date well completed firm name county well located

LANDOWNER:	description of formations encountered	from	to
<i>Rhanel Declaux</i>			
(mailing address)	<i>Red Clay</i>	<i>2</i>	<i>18</i>
WELL LOCATION:	<i>Hard Sand</i>	<i>18</i>	<i>58</i>
sec. <i>28</i> T. <i>3</i> N. R. <i>11</i> E.	<i>Course Sand</i>	<i>58</i>	<i>73</i>
<i>3</i> miles <i>SE</i> of <i>Perk</i>			
(distance) (direction) (nearest town)			
WELL PURPOSE: <i>HOME</i>			
(home, irrigation, municipal, industrial)			
WELL COMPLETION DATA:			
(1) diameter (inches) <i>2"</i>			
(2) total depth (feet) <i>73'</i>			
(3) static water level (feet) <i>50'</i> below top of ground.			
(4) casing <i>Plastic, 68'</i>			
(material) (depth)			
(size) If telescope see back.			
(5) screen <i>5' 68'</i>			
(length) (depth to top)			
<i>2"</i> <i>Plastic</i>			
(size) (material)			
(6) pump <i>1</i> <i>9</i>			
(HP) (yield gpm)			
<i>Elect</i>			
(type power)			
(7) electric log <i>no</i>			
(yes or no)			
(organization running log)			
(8) how well bottom plugged <i>Clipped</i>			
DRILLERS REMARKS:			


RECEIVED  
 RB

JAN - 4 1978

MISS. BD. OF WATER COMM

If well telescopes please sketch and show depths.

GROUND LEVEL

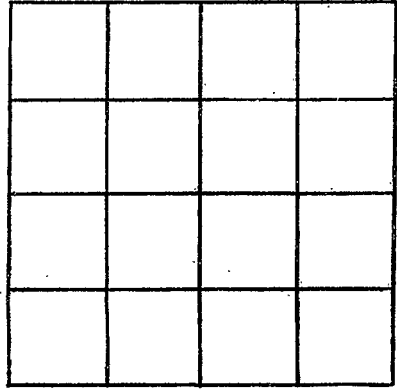

SECTION \_\_\_\_\_

Please indicate well location X.

ADDITIONAL INFORMATION

If more than one screen,  
show locations of each on sketch.