

Stone  
 B 2025  
 12/7/77

MISSISSIPPI  
 BOARD OF WATER COMMISSIONERS  
 416 North State Street  
 Jackson, Mississippi 39201

WATER WELL DRILLERS LOG

12-7 1977 Parnell Anderson Stone  
 date well completed firm name county well located


LANDOWNER:	description of formations encountered	from	to
Moel Mann	Top Soil	0	3
(mailing address)	Coarse Sand	3	24
WELL LOCATION:	B. In Clay	24	109
sec. 19 T 3 N R 11 E S W	Coarse Sand	109	125
1 miles S of Perk			
(distance) (direction) of (nearest town)			
WELL PURPOSE: HOME (home, irrigation, municipal, industrial)			
WELL COMPLETION DATA:			
(1) diameter (inches) 2"			
(2) total depth (feet) 125'			
(3) static water level (feet) 40' below top of ground.			
(4) casing Plastic, 120' (material) (depth)			
(size) if telescope see back.			
(5) screen 5' 120' (length) (depth to top)			
2" Plastic (size) (material)			
(6) pump 1 HP 10 (yield gpm)			
Electric (type power)			
(7) electric log no (yes or no)			
(organization running log)			
(8) how well bottom plugged Capped			
DRILLERS REMARKS:			

RECEIVED  
 ALL  
 JAN - 4 1979

MISS. Bd. OF WATER COMMISSIONERS

If well telescopes please sketch and show depths.

GROUND LEVEL

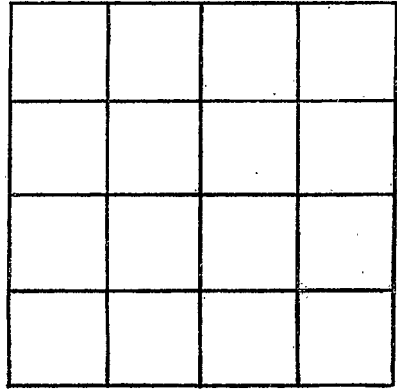

SECTION \_\_\_\_\_

Please indicate well location X.

ADDITIONAL INFORMATION

If more than one screen, show locations of each on sketch.