

Stone
 Lb 2000
 3/21/78

MISSISSIPPI
 BOARD OF WATER COMMISSIONERS
 416 North State Street
 Jackson, Mississippi 39201

WATER WELL DRILLERS LOG

3-21-78 *Kimell Anderson* Stone
 date well completed firm name county well located

LANDOWNER: *Ronnie willison*
 (mailing address)

description of formations encountered	from	to
<i>Top Soil</i>	<i>0</i>	<i>3</i>
<i>Sandy clay</i>	<i>3</i>	<i>22</i>
<i>Clay Sand</i>	<i>22</i>	<i>43</i>

WELL LOCATION:
 sec. *33* T. *3* N. R. *11* E
3 miles *SE* of *Park*
 (distance) (direction) (nearest town)

WELL PURPOSE: *HOME*
 (home, irrigation, municipal, industrial)


- WELL COMPLETION DATA:
- (1) diameter (inches) *2"*
 - (2) total depth (feet) *43'*
 - (3) static water level (feet) *28* below above top of ground.
 - (4) casing *Plastic* *38'*
 (material) (depth)
 (size) if telescope see back.
 - (5) screen *6'* *38'*
 (length) (depth to top)
2" *Plastic*
 (size) (material)
 - (6) pump *1* *8*
 (HP) (yield gpm)
Elect
 (type power)
 - (7) electric log *no*
 (yes or no)
 (organization running log)
 - (8) how well bottom plugged *Capped*

RECEIVED
 APR - 7 1978

DRILLERS REMARKS:
 MISS. BD. OF WATER COMM.

If well telescopes please sketch and show depths.

GROUND LEVEL

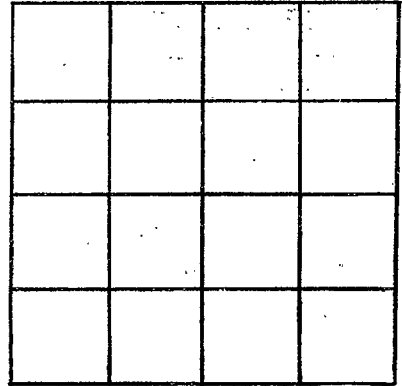

SECTION _____

Please indicate well location X.

ADDITIONAL INFORMATION

If more than one screen,
show locations of each on sketch.