

STONE  
G  
2028  
5-5-78

MISSISSIPPI  
BOARD OF WATER COMMISSIONERS  
416 North State Street  
Jackson, Mississippi 39201

WATER WELL DRILLERS LOG

5-5-78 1978 *Samuel Anderson* Stone  
date well completed firm name county well located


LANDOWNER:	description of formations encountered	from	to
<i>Everett Breland</i>	<i>Top Soil</i>	0	3
(mailing address)	<i>Pink Clay</i>	3	35
WELL LOCATION:	<i>Fine Sand</i>	35	72
sec. <i>9</i> T <i>3</i> N R <i>11</i> W S	<i>Course Sand</i>	72	98
<i>5</i> miles <i>SE</i> of <i>W. Leggett</i>			
(distance) (direction) (nearest town)			
WELL PURPOSE: <i>HOME</i>			
(home, irrigation, municipal, industrial)			
WELL COMPLETION DATA:			
(1) diameter (inches) <i>2"</i>			
(2) total depth (feet) <i>98'</i>			
(3) static water level (feet) <i>32</i> below top of ground.			
(4) casing <i>Plastic, 25'</i>			
(material) (depth)			
(size) If telescope see back.			
(5) screen <i>3'</i> , <i>93'</i>			
(length) (depth to top)			
<i>2"</i> , <i>Plastic</i>			
(size) (material)			
(6) pump <i>1</i> , <i>12</i>			
(HP) (yield gpm)			
<i>Elect</i>			
(type power)			
(7) electric log <i>No</i>			
(yes or no)			
(organization running log)			
(8) how well bottom plugged <i>Capped</i>			
DRILLERS REMARKS:			

REGISTERED  
JUN - 2 1978

MISS. BD. OF WATER COMMISSIONERS

If well telescopes please sketch and show depths.

GROUND LEVEL

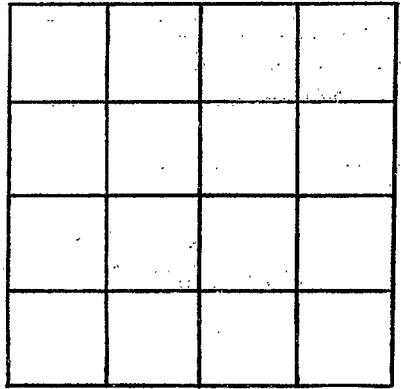

SECTION \_\_\_\_\_

Please indicate well location X.

ADDITIONAL INFORMATION

If more than one screen,  
show locations of each on sketch.