

STONE
G 2025
5-12-78

MISSISSIPPI
BOARD OF WATER COMMISSIONERS
416 North State Street
Jackson, Mississippi 39201

WATER WELL DRILLERS LOG


5-12-1978 *Parrell Williams* Stone
date well completed firm name county well located

LANDOWNER:	description of formations encountered	from	to
<i>Coy Bond</i>			
(mailing address)	<i>1st Sand</i>	<i>3</i>	<i>65</i>
WELL LOCATION:	<i>Crude Sand</i>	<i>68</i>	<i>85</i>
sec. <i>2</i> T. <i>3</i> R. <i>11</i> E. <i>6</i> miles <i>SE</i> of <i>Weylan</i> (distance) (direction) (nearest town)			
WELL PURPOSE: <i>HOME</i> (home, irrigation, municipal, industrial)			
WELL COMPLETION DATA:			
(1) diameter (inches) <i>2"</i>			
(2) total depth (feet) <i>85'</i>			
(3) static water level (feet) <i>47</i> below top of ground.			
(4) casing <i>Plastic</i> <i>80'</i> (material) (depth)			
(size) if telescope see back.			
(5) screen <i>5'</i> <i>80'</i> (length) (depth to top)			
<i>2"</i> <i>Plastic</i> (size) (material)			
(6) pump <i>1</i> <i>8</i> (HP) (yield gpm)			
<i>Electric</i> (type power)			
(7) electric log <i>No</i> (yes or no)			
(organization running log)			
(8) how well bottom plugged <i>Capped</i>			
DRILLERS REMARKS:			

RECEIVED
JUN - 2 1978
MISS. BD. OF WATER COMMISSIONERS

If well telescopes please sketch and show depths.

GROUND LEVEL

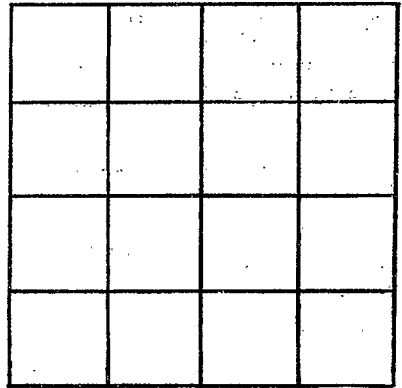

SECTION _____

Please indicate well location X.

ADDITIONAL INFORMATION

If more than one screen,
show locations of each on sketch.