

STONE
G 2031
10-3-78

**MISSISSIPPI
BOARD OF WATER COMMISSIONERS**
416 North State Street
Jackson, Mississippi 39201

WATER WELL DRILLERS LOG

10-3 1978 Pamell Anderson Stone
 date well completed firm name county well located


LANDOWNER:	description of formations encountered	from	to
<u>Tommy Osborn</u>			
(mailing address)	<u>White Clay</u>	<u>1</u>	<u>8</u>
WELL LOCATION:	<u>Collie Sand</u>	<u>8</u>	<u>6.3'</u>
sec. <u>3</u> T <u>3</u> N R <u>11</u> E S <u>W</u>			
<u>5</u> miles <u>SE</u> of <u>Wiggins</u>			
(distance) (direction) (nearest town)			
WELL PURPOSE: <u>HOME</u>			
(home, irrigation, municipal, industrial)			
WELL COMPLETION DATA:			
(1) diameter (inches) <u>2</u>			
(2) total depth (feet) <u>63'</u>			
(3) static water level (feet) <u>10'</u> below top of ground.			
(4) casing <u>Plastic</u> <u>5-8'</u>			
(material) (depth)			
_____ if telescope see back.			
(size)			
(5) screen <u>5'</u> <u>5-8'</u>			
(length) (depth to top)			
<u>2"</u> <u>Plastic</u>			
(size) (material)			
(6) pump <u>1</u> <u>15'</u>			
(HP) (yield gpm)			
<u>Elect</u>			
(type power)			
(7) electric log <u>no</u>			
(yes or no)			

(organization running log)			
(8) how well bottom plugged <u>Capped</u>			
DRILLERS REMARKS:			

RECEIVED
 NOV - 1 1978
 MISS. BD. OF WATER COMMISSIONERS

If well telescopes please sketch and show depths.

GROUND LEVEL

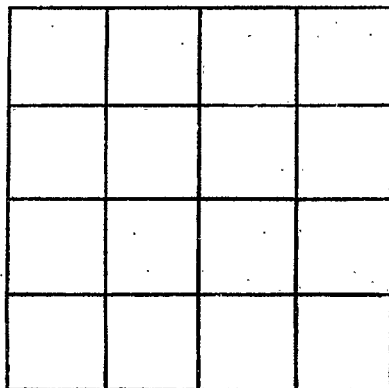

SECTION _____

Please indicate well location X.

ADDITIONAL INFORMATION

If more than one screen,
show locations of each on sketch.