

STONE
G 2033
04-18-79

MISSISSIPPI
BOARD OF WATER COMMISSIONERS
416 North State Street
Jackson, Mississippi 39201

WATER WELL DRILLERS LOG

4-18-1979 Panel Adams Stone
date well completed firm name county well located

LANDOWNER:	description of formations encountered	from	to
<u>W.C. Davis</u>			
(mailing address)	<u>Final Sand</u>	<u>3</u>	<u>74</u>
WELL LOCATION:	<u>Course Sand</u>	<u>44</u>	<u>65</u>
sec. <u>3</u> T. <u>3</u> N. <u>3</u> R. <u>11</u> E. S. <u>5</u> W. <u>W. Eggen</u>			
<u>4 1/2</u> miles <u>SE</u> of <u>W. Eggen</u> (distance) (direction) (nearest town)			
WELL PURPOSE: <u>HOME</u> (home, irrigation, municipal, industrial)			
WELL COMPLETION DATA:			
(1) diameter (inches) <u>2"</u>			
(2) total depth (feet) <u>65'</u>			
(3) static water level (feet) <u>7'</u> below above top of ground.			
(4) casing <u>Plastic, 60'</u> (material) (depth)			
(size) if telescope see back.			
(5) screen <u>5"</u> , <u>60'</u> (length) (depth to top)			
<u>2"</u> , <u>Plastic</u> (size) (material)			
(6) pump <u>1</u> <u>10</u> (HP) (yield gpm)			
<u>Elec</u> (type power)			
(7) electric log <u>no</u> (yes or no)			
(organization running log)			
(8) how well bottom plugged <u>Capped</u>			
DRILLERS REMARKS:			


MISS. BOARD OF WATER COMM.

MAY - 7 1979

RECEIVED

If well telescopes please sketch and show depths.

GROUND LEVEL

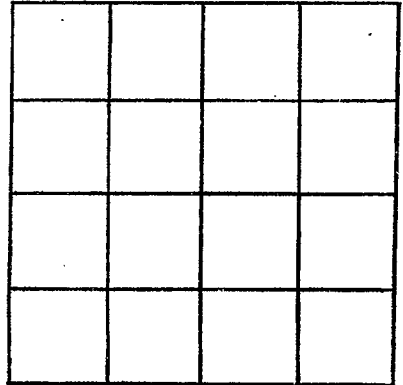

SECTION _____

Please indicate well location X.

ADDITIONAL INFORMATION

If more than one screen,
show locations of each on sketch.