

Stone
G 2034
5-15-79

MISSISSIPPI
BOARD OF WATER COMMISSIONERS
416 North State Street
Jackson, Mississippi 39201

WATER WELL DRILLERS LOG

5-15-1979
date well completed

Parnell Pedersen
firm name

Stone
county well located

LANDOWNER:	description of formations encountered	from	to
Keith Kirkland	Top Soil	0	2
(mailing address)	clay	2	28
WELL LOCATION:	7 in sand	28	31
sec. 2 T 3 N R 11 E S W	clay	31	65
5 miles SE of Wiggins (distance) (direction) (nearest town)	7 in sand	65	95
WELL PURPOSE: HOME (home, irrigation, municipal, industrial)	course sand	95	121
WELL COMPLETION DATA:			
(1) diameter (inches) 2"			
(2) total depth (feet) 121			
(3) static water level (feet) 57 below top of ground.			
(4) casing Plastic 116' (material) (depth)			
(size) if telescope see back.			
(5) screen 5' 116' (length) (depth to top)			
2" Plastic (size) (material)			
(6) pump 1 8 (HP) (yield gpm)			
Elect (type power)			
(7) electric log no (yes or no)			
(organization running log)			
(8) how well bottom plugged Capped			
DRILLERS REMARKS:			


Miss. Board of Water Comm.

JUN - 8 1979

RECEIVED

If well telescopes please sketch and show depths.

GROUND LEVEL

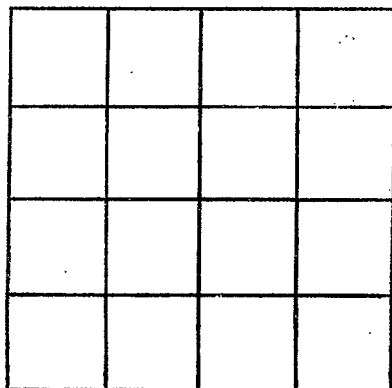

SECTION _____

Please indicate well location X.

ADDITIONAL INFORMATION

If more than one screen,
show locations of each on sketch.