

STONE
 G 2035
 7-10-79

MISSISSIPPI
 BOARD OF WATER COMMISSIONERS
 416 North State Street
 Jackson, Mississippi 39201

WATER WELL DRILLERS LOG

7-10-1979 Parnell Anderson Stone
 date well completed firm name county well located

LANDOWNER:
Mike Towles
 (mailing address)

WELL LOCATION:
 sec. 12 T. 3 N. R. 11 W.
6 miles NE of Park
 (distance) (direction) (nearest town)

WELL PURPOSE: HOME
 (home, irrigation, municipal, industrial)

WELL COMPLETION DATA:

(1) diameter (inches) 3"

(2) total depth (feet) 105'

(3) static water level (feet) 82 below top of ground.

(4) casing Plastic, 100'
 (material) (depth)

if telescope see back.
 (size)

(5) screen 3', 100'
 (length) (depth to top)

3", Plastic
 (size) (material)

(6) pump 1, 12
 (HP) (yield gpm)

Elect
 (type power)

(7) electric log no
 (yes or no)

(organization running log)

(8) how well bottom plugged
Capped

description of formations encountered	from	to
Top Soil	0	2
Red Clay	2	45
Dark Clay	45	80
Fin Sand	80	92
Coarse Sand	92	105

Miss. Board of Water Comm.


AUG 10 1979

RECEIVED

DRILLERS REMARKS:

If well telescopes please sketch and show depths.

GROUND LEVEL

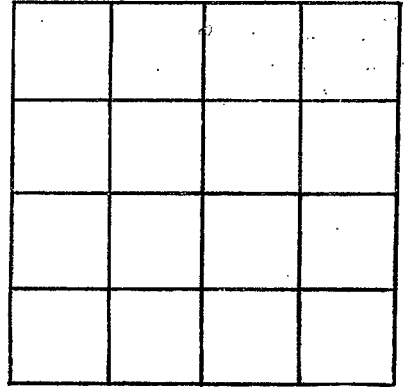

SECTION _____

Please indicate well location X.

ADDITIONAL INFORMATION

If more than one screen,
show locations of each on sketch.