

Stone
 G 2030
 6-13-79

MISSISSIPPI
 BOARD OF WATER COMMISSIONERS
 416 North State Street
 Jackson, Mississippi 39201

WATER WELL DRILLERS LOG


6-13 1979 Parrell Anderson Stone
 date well completed firm name county well located

LANDOWNER:	description of formations encountered	from	to
John Dickens	Top Soil	0	2
(mailing address)	clay	2	15
WELL LOCATION: sec. <u>14</u> T. <u>3</u> R. <u>11</u> <u>4 1/2</u> miles <u>E</u> of <u>Perk</u> (distance) (direction) (nearest town)	Columb Sand	15	21
WELL PURPOSE: <u>HOME</u> (home, irrigation, municipal, industrial)			
WELL COMPLETION DATA:			
(1) diameter (inches) <u>2"</u>			
(2) total depth (feet) <u>81"</u>			
(3) static water level (feet) <u>28</u> below top of ground.			
(4) casing <u>Plastic</u> (material) (depth) (size) if telescope see back.			
(5) screen <u>5'</u> <u>76"</u> (length) (depth to top) <u>2"</u> <u>Plastic</u> (size) (material)			
(6) pump <u>1</u> <u>13</u> (HP) (yield gpm) <u>Colect</u> (type power)			
(7) electric log <u>NO</u> (yes or no) (organization running log)			
(8) how well bottom plugged <u>Capped</u>			
DRILLERS REMARKS:			

Miss. Board of Water Comm.
 JUL 11 1979
 RECEIVED

If well telescopes please sketch and show depths.

GROUND LEVEL

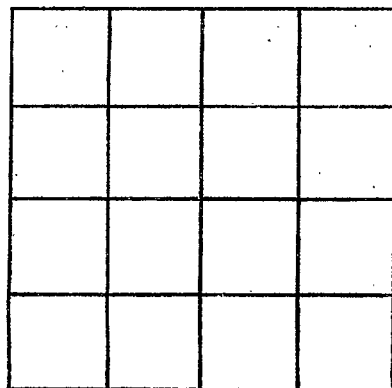

SECTION _____

Please indicate well location X.

ADDITIONAL INFORMATION

If more than one screen, show locations of each on sketch.