

Stone  
G0037  
8-2-79

MISSISSIPPI  
BOARD OF WATER COMMISSIONERS  
416 North State Street  
Jackson, Mississippi 39201

WATER WELL DRILLERS LOG

8-2  
date well completed

1979 *Samuel Anderson*  
firm name

*Stone*  
county well located

LANDOWNER:

*Ottis Fidelity*

(mailing address)

WELL LOCATION:

sec. 29 T. 3 N R. 11 E  
S  
2 miles SE of Berk  
(distance) (direction) (nearest town)

WELL PURPOSE: HOME  
(home, irrigation, municipal, industrial)

WELL COMPLETION DATA:

- (1) diameter (inches) 2"
- (2) total depth (feet) 45'
- (3) static water level (feet) 39' below above top of ground.
- (4) casing P. Plastic 40'  
(material) (depth)
- \_\_\_\_\_ If telescope see back.  
(size)
- (5) screen 5' 40'  
(length) (depth to top)
- 2" P. Plastic  
(size) (material)
- (6) pump 1 8  
(HP) (yield gpm)
- Clect  
(type power)
- (7) electric log No  
(yes or no)

(organization running log)

(8) how well bottom plugged Capped

description of formations encountered

from to

*Top Soil* 0 2  
*Clay* 2 18  
*Fin. Sand* 18 45


DRILLERS REMARKS:

SEP 11 1979

RECEIVED

If well telescopes please sketch and show depths.

GROUND LEVEL

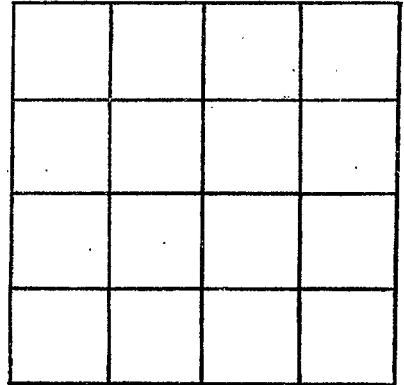

SECTION \_\_\_\_\_

Please indicate well location X.

ADDITIONAL INFORMATION

If more than one screen,  
show locations of each on sketch.