

Stone
G2038
8-3-79

MISSISSIPPI
BOARD OF WATER COMMISSIONERS
416 North State Street
Jackson, Mississippi 39201

WATER WELL DRILLERS LOG

8-3
date well completed

1979 Parnell Anderson
firm name

Stone
county well located

LANDOWNER:

Mike Natten

(mailing address)

WELL LOCATION:

sec. 1 T. 3 N. R. 11 W. S. 5 miles (distance) of Whites Cross (direction) of (nearest town)

WELL PURPOSE: HOME
(home, irrigation, municipal, industrial)

WELL COMPLETION DATA:

- (1) diameter (inches) 2"
- (2) total depth (feet) 105'
- (3) static water level (feet) 44' below top of ground.
- (4) casing Plastic (material) 100' (depth)

(size) if telescope see back.

- (5) screen 5' (length) 100' (depth to top)
2" (size) Plastic (material)
- (6) pump 1 (HP) 10 (yield gpm)
Electric (type power)
- (7) electric log no (yes or no)

(organization running log)

- (8) how well bottom plugged Capped

DRILLERS REMARKS:

description of formations encountered

from to

<u>Topsoil</u>	<u>0</u>	<u>2</u>
<u>Red & Gray clay</u>	<u>2</u>	<u>25</u>
<u>Flint Sand</u>	<u>25</u>	<u>66</u>
<u>Clay</u>	<u>66</u>	<u>80</u>
<u>Coarse Sand</u>	<u>80</u>	<u>105</u>


Miss. Board of Water Comm.

SEP 11 1979

RECEIVED

If well telescopes please sketch and show depths.

GROUND LEVEL

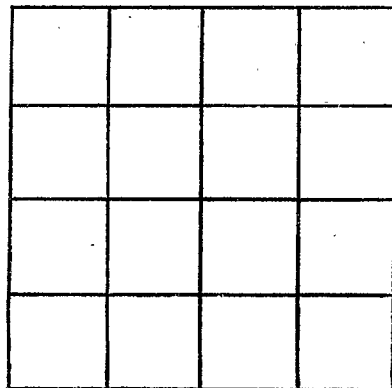

SECTION _____

Please indicate well location X.

ADDITIONAL INFORMATION

If more than one screen,
show locations of each on sketch.