

Stone
G 2040

MISSISSIPPI
BOARD OF WATER COMMISSIONERS
416 North State Street
Jackson, Mississippi 39201

WATER WELL DRILLERS LOG

10-10-79
10-10-1979

1979 Shinnell Anderson Stone
date well completed firm name county well located

LANDOWNER:	description of formations encountered	from	to
<u>E. R. Johnson</u>	<u>Top soil</u>	0	2
(mailing address)	<u>Fine sand</u>	2	35
WELL LOCATION:	<u>Clay</u>	35	45
sec. <u>23</u> T. <u>3</u> R. <u>11</u> S. <u>E</u> of <u>Clark</u> (distance) (direction) (nearest town)	<u>Course sand</u>	45	105
WELL PURPOSE: <u>HOME</u> (home, irrigation, municipal, industrial)			
WELL COMPLETION DATA:			
(1) diameter (inches) <u>2"</u>			
(2) total depth (feet) <u>105'</u>			
(3) static water level (feet) <u>18'</u> below top of ground.			
(4) casing <u>Plastic</u> , <u>100'</u> (material) (depth) (size) if telescope see back.			
(5) screen <u>5'</u> , <u>100'</u> (length) (depth to top)			
<u>2"</u> , <u>Plastic</u> (size) (material)			
(6) pump <u>1</u> , <u>12</u> (HP) (yield gpm)			
<u>Elect</u> (type power)			
(7) electric log <u>no</u> (yes or no)			
(organization running log)			
(8) how well bottom plugged <u>Capped</u>			
DRILLERS REMARKS:			


DEPT. OF NATURAL RESOURCES
BUREAU OF LAND & WATER RESOURCES

NOV 20 1979

RECEIVED

If well telescopes please sketch and show depths.

GROUND LEVEL

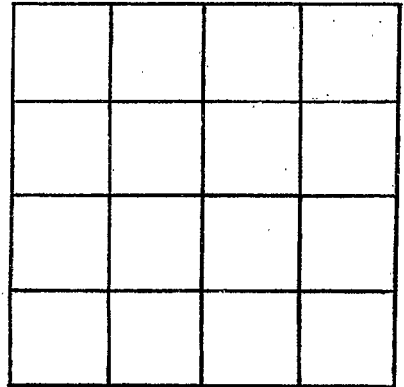

SECTION _____

Please indicate well location X.

ADDITIONAL INFORMATION

If more than one screen,
show locations of each on sketch.