

Stone
 G 2041
 11-5-79

MISSISSIPPI
 BOARD OF WATER COMMISSIONERS
 416 North State Street
 Jackson, Mississippi 39201

WATER WELL DRILLERS LOG

11-5-1979 date well completed
 Parmer & Melburn firm name
 Stone county well located

LANDOWNER:
 Joel Miles
 (mailing address)
 WELL LOCATION:
 sec. 32 T. 3 N. R. 11 E.
 3 miles S E of Perk
 (distance) (direction) (nearest town)

description of formations encountered	from	to
Top Soil	0	2
Course Sand	2	37
Clay	37	50
Fine Sand	50	97

WELL PURPOSE: HOME
 (home, irrigation, municipal, industrial)

WELL COMPLETION DATA:
 (1) diameter (inches) 2"
 (2) total depth (feet) 97'
 (3) static water level (feet) 43' below top of ground.
 (4) casing Plastic, 92' (material) (depth)
 (size) If telescope see back.
 (5) screen 5" length, 92' depth to top
 2" Plastic (size) (material)
 (6) pump 1 (HP) 6 (yield gpm)
 Elect (type power)
 (7) electric log no (yes or no)
 (organization running log)
 (8) how well bottom plugged Capped

DRILLERS REMARKS:


DEPT. OF NATURAL RESOURCES
 BUREAU OF LAND & WATER RESOURCES

DEC 10 1979

RECEIVED

If well telescopes please sketch and show depths.

GROUND LEVEL

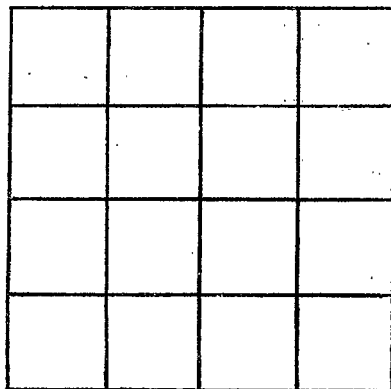

SECTION _____

Please indicate well location X.

ADDITIONAL INFORMATION

If more than one screen,
show locations of each on sketch.