

Stone
G 2043
4-20-79

MISSISSIPPI
BOARD OF WATER COMMISSIONERS
416 North State Street
Jackson, Mississippi 39201

WATER WELL DRILLERS LOG

April 20 1979 Duncan Well Drilling Stone
date well completed firm name county well located

LANDOWNER: <u>Dealus Vickman</u>	description of formations encountered	from	to
<u>Rt. 3 Box, 74 B</u>			
<u>Perkinston, Ms.</u> (mailing address)	<u>Sand</u>	<u>0</u>	<u>15</u>
WELL LOCATION:	<u>Clay</u>	<u>15</u>	<u>190</u>
sec <u>33</u> T. <u>3</u> N R. <u>11</u> E <u>6</u> miles <u>NE</u> of <u>McHenry</u> (distance) (direction) (nearest town)	<u>Fine Sand</u>	<u>190</u>	<u>215</u>
WELL PURPOSE: <u>Home</u> (home, irrigation, municipal, industrial)	<u>Coarse Sand</u>	<u>215</u>	<u>228</u>
WELL COMPLETION DATA:			
(1) diameter (inches) <u>2"</u>			
(2) total depth (feet) <u>228 ft.</u>			
(3) static water level (feet) <u>120'</u> below top of ground.			
(4) casing <u>PVC</u> , <u>110'</u> (material) (depth)			
<u> </u> if telescope see back. (size)			
(5) screen <u>10'</u> , <u>110'</u> (length) (depth to top)			
(6) pump <u>2"</u> , <u>PVC</u> (size) (material)			
(6) pump <u>1 sub.</u> , <u>10</u> (HP) (yield gpm)			
(6) pump <u>electric</u> (type power)			
(7) electric log <u> </u> (yes or no)			
<u> </u> (organization running log)			
(8) how well bottom plugged <u>Sand</u> <u>Shark</u>			
DRILLERS REMARKS:			


DEPT. OF NATURAL RESOURCES
BUREAU OF LAND & WATER RESOURCES

JUN 15 1980

RECEIVED

If well telescopes please sketch and show depths.

GROUND LEVEL

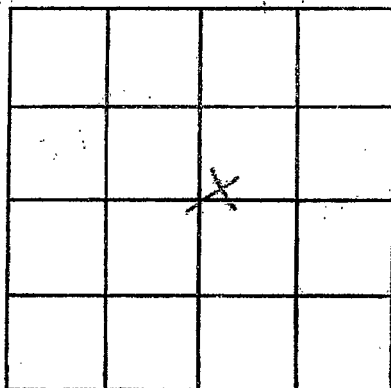

SECTION ~~33~~

Please indicate well location X.

ADDITIONAL INFORMATION

If more than one screen,
show locations of each on sketch.