

Stone
G 2044
5-14-79

MISSISSIPPI
BOARD OF WATER COMMISSIONERS
416 North State Street
Jackson, Mississippi 39201

WATER WELL DRILLERS LOG

5-14 1979 Garnell Peterson Stone
date well completed firm name county well located

LANDOWNER:
Lomes Parker

(mailing address)

description of formations encountered	from	to
<u>Top Soil</u>	<u>0</u>	<u>2</u>
<u>clay</u>	<u>2</u>	<u>35</u>
<u>Course Sand</u>	<u>35</u>	<u>75</u>

WELL LOCATION:
sec. 5 T. 3 N. R. 11 E. S. 4 W.
2 1/2 miles S of W. Lehigh
(distance) (direction) (nearest town)

WELL PURPOSE: HOME
(home, irrigation, municipal, industrial)

- WELL COMPLETION DATA:
- (1) diameter (inches) 2"
 - (2) total depth (feet) 75'
 - (3) static water level (feet) 25' below top of ground
 - (4) casing Plastic 70'
(material) (depth)
 - (size) If telescope see back.
 - (5) screen 5" 70'
(length) (depth to top)
 - 2" Plastic
(size) (material)
 - (6) pump 1 1/2
(HP) (yield gpm)
 - Elect
(type power)
 - (7) electric log no
(yes or no)
 - (organization running log)
 - (8) how well bottom plugged capped

Miss. Board of Water Comm.


JUN - 8 1979

DRILLERS REMARKS:

RECEIVED

If well telescopes please sketch and show depths.

GROUND LEVEL

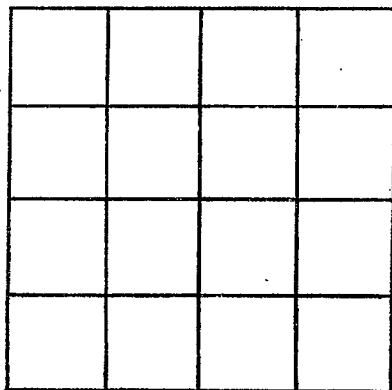

SECTION _____

Please indicate well location X.

ADDITIONAL INFORMATION

If more than one screen,
show locations of each on sketch.