

Stone
 G 2045
 June 6, 1979

MISSISSIPPI
 BOARD OF WATER COMMISSIONERS
 416 North State Street
 Jackson, Mississippi 39201

WATER WELL DRILLERS LOG


6-6 1979 *Samuel Anderson Stone*
 date well completed firm name county well located

LANDOWNER:	description of formations encountered	from	to
<i>Elesibth Rogers</i>			
(mailing address)	<i>Mudgy Clay</i>	<i>7</i>	<i>25</i>
WELL LOCATION:	<i>Clay</i>	<i>25</i>	<i>38</i>
sec. <i>6</i> T. <i>3</i> N. R. <i>11</i> E. S. <i>5</i> W. <i>Wiggins</i>	<i>Fine Sand</i>	<i>38</i>	<i>50</i>
<i>2</i> miles (distance) <i>S</i> (direction) of <i>Wiggins</i> (nearest town)	<i>Course Mud</i>	<i>50</i>	<i>81</i>
WELL PURPOSE: <i>HOME</i> (home, irrigation, municipal, industrial)			
WELL COMPLETION DATA:			
(1) diameter (inches) <i>2"</i>			
(2) total depth (feet) <i>81</i>			
(3) static water level (feet) <i>35'</i> below top of ground			
(4) casing <i>Plastic 76'</i> (material) (depth)			
(size) if telescope see back.			
(5) screen <i>5"</i> , <i>76'</i> (length) (depth to top)			
<i>2"</i> , <i>Plastic</i> (size) (material)			
(6) pump <i>1</i> , <i>10</i> (HP) (yield gpm)			
<i>Direct</i> (type power)			
(7) electric log <i>No</i> (yes or no)			
(organization running log)			
(8) how well bottom plugged <i>Plugged</i>			
DRILLERS REMARKS:			

Miss. Board of Water Comm.
 JUL 11 1979
 RECEIVED

If well telescopes please sketch and show depths.

GROUND LEVEL

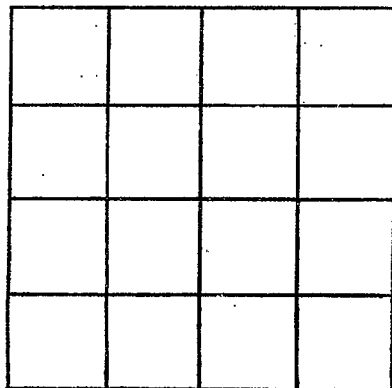

SECTION _____

Please indicate well location X.

ADDITIONAL INFORMATION

If more than one screen,
show locations of each on sketch.