

Stone  
 G 2046  
 June 7, 1979

MISSISSIPPI  
 BOARD OF WATER COMMISSIONERS  
 416 North State Street  
 Jackson, Mississippi 39201

WATER WELL DRILLERS LOG


6-7 date well completed  
 1979 Pennell Anderson firm name  
 Stone county well located

LANDOWNER:	description of formations encountered	from	to
C.C. Morris			
(mailing address)	Sandy Clay	2	23
WELL LOCATION:	Clay	23	35
sec. 6 T. 3 S. R. 11 E. W. 4	Course Sand	35	78
2 miles S of Vicksburg			
(distance) (direction) (nearest town)			
WELL PURPOSE: HOME			
(home, irrigation, municipal, industrial)			
WELL COMPLETION DATA:			
(1) diameter (inches) 2"			
(2) total depth (feet) 78			
(3) static water level (feet) 35 below top of ground			
(4) casing Plastic 73' (material) (depth)			
(size) If telescope see back.			
(5) screen 5' 73' (length) (depth to top)			
2" Plastic (size) (material)			
(6) pump 1 (HP) 11 (yield gpm)			
Elect (type power)			
(7) electric log No (yes or no)			
(organization running log)			
(8) how well bottom plugged Plugged			
DRILLERS REMARKS:			

Miss. Board of Water Comm.  
 JUL 11 1979  
 RECEIVED

If well telescopes please sketch and show depths.

GROUND LEVEL

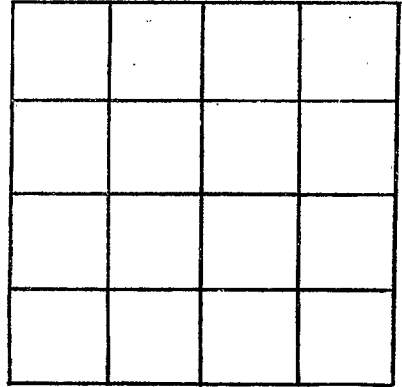

SECTION \_\_\_\_\_

Please indicate well location X.

ADDITIONAL INFORMATION

If more than one screen,  
show locations of each on sketch.