

STONE
G 2048
7-17-79

**MISSISSIPPI  
BOARD OF WATER COMMISSIONERS**  
416 North State Street  
Jackson, Mississippi 39201

**WATER WELL DRILLERS LOG**

7-17 1979 Perme Al Pederson Stone  
 date well completed                      firm name                      county well located

LANDOWNER:	description of formations encountered	from	to
<u>Ray Sumrall</u>			
(mailing address)	<u>Red Clay</u>	<u>2</u>	<u>24</u>
WELL LOCATION:	<u>Fluv Sand</u>	<u>24</u>	<u>44</u>
sec. <u>5</u> T. <u>3</u> N. R. <u>11</u> E. S. <u>5</u> W. <u>12</u>	<u>Clay</u>	<u>44</u>	<u>48</u>
<u>2</u> miles <u>N</u> of <u>Perla</u>	<u>Fluv Sand</u>	<u>48</u>	<u>82</u>
(distance) (direction) (nearest town)	<u>Course Sand</u>	<u>82</u>	<u>95</u>
WELL PURPOSE: <u>HOME</u> (home, irrigation, municipal, industrial)			
WELL COMPLETION DATA:			
(1) diameter (inches) <u>2"</u>			
(2) total depth (feet) <u>95'</u>			
(3) static water level (feet) <u>40'</u> below top of ground.			
(4) casing <u>Plastic, 90'</u> (material) (depth)			
(size) If telescope see back.			
(5) screen <u>5"</u> , <u>90'</u> (length) (depth to top)			
<u>2"</u> , <u>Plastic</u> (size) (material)			
(6) pump <u>1</u> <u>12</u> (HP) (yield gpm)			
<u>Elect.</u> (type power)			
(7) electric log <u>NO</u> (yes or no)			
(organization running log)			
(8) how well bottom plugged <u>Capped</u>			
DRILLERS REMARKS:			


Miss. Board of Water Comm.

AUG 10 1979

**RECEIVED**

If well telescopes please sketch and show depths.

GROUND LEVEL

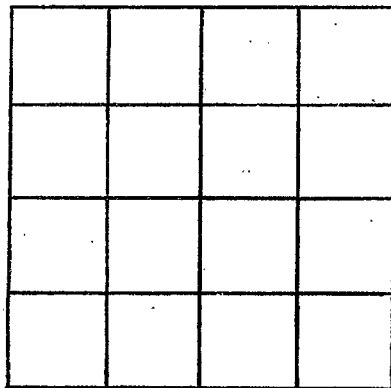

SECTION \_\_\_\_\_

Please indicate well location X.

ADDITIONAL INFORMATION

If more than one screen,  
show locations of each on sketch.