

MISSISSIPPI  
BOARD OF WATER COMMISSIONERS  
416 North State Street  
Jackson, Mississippi 39201

**WATER WELL DRILLERS LOG**

Stone  
G 2045  
Oct. 13, 1979

10-13-79 Bradley Pumpwell Stone  
date well completed firm name county well located  
Service, Inc

LANDOWNER: Robert Seal

Rt 1, Box 13-A

Wiggins, MS 39577  
(mailing address)

description of formations encountered	from	to
	<u>Clay</u> <u>Sand</u>	<u>0</u> <u>18</u>

WELL LOCATION:  
sec. 6 T. 3 N. R. 11 E.  
S. W.  
2 miles S of Wiggins  
(distance) (direction) (nearest town)

WELL PURPOSE: home  
(home, irrigation, municipal, industrial)

WELL COMPLETION DATA:

- (1) diameter (inches) 2"
- (2) total depth (feet) 80'
- (3) static water level (feet) 25' below top of ground.
- (4) casing PVC total  
(material) (depth)  
2" If telescope see back.  
(size)
- (5) screen 5' 75'  
(length) (depth to top)  
2" 008 PVC underbar  
(size) (material)
- (6) pump 1 10  
(HP) (yield gpm)  
230V 10  
(type power)
- (7) electric log NO  
(yes or no)

(organization running log)

(8) how well bottom plugged:  
2" sand shark


DRILLERS REMARKS:  
No tail pipe

DEPT. OF NATURAL RESOURCES  
BUREAU OF LAND & WATER RESOURCES

JAN 17 1980  
**RECEIVED**

If well telescopes please sketch and show depths.

GROUND LEVEL

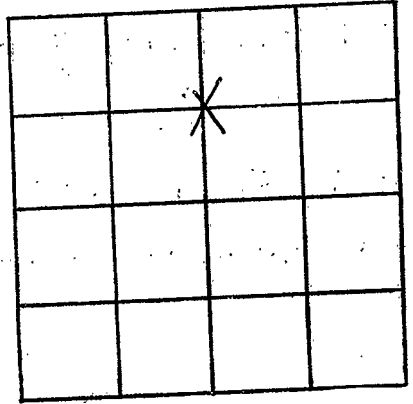

SECTION 6

Please indicate well location X.

ADDITIONAL INFORMATION

If more than one screen, show locations of each on sketch.