

Stone

G 2051

11-6-79

MISSISSIPPI
 BOARD OF WATER COMMISSIONERS
 416 North State Street
 Jackson, Mississippi 39201

WATER WELL DRILLERS LOG

11-6
date well completed

1979 Pamell Anderson
firm name

Stone
county well located

LANDOWNER:

Billy Anderson

(mailing address)

WELL LOCATION:

sec. 6 T. 3 N. R. 11 E.
 (distance) (direction) (nearest town)
1 miles S of Wiggins

WELL PURPOSE: HOME
 (home, irrigation, municipal, industrial)

WELL COMPLETION DATA:

- (1) diameter (inches) 2"
- (2) total depth (feet) 123'
- (3) static water level (feet) 21' below top of ground.
- (4) casing Plastic, 118'
 (material) (depth)
- _____ If telescope see back.
 (size)
- (5) screen 5', 118'
 (length) (depth to top)
- 2", Plastic
 (size) (material)
- (6) pump 1, 10
 (HP) (yield gpm)
- Elect
 (type power)
- (7) electric log no
 (yes or no)

(organization running log)

(8) how well bottom plugged

Capped

DRILLERS REMARKS:

description of formations encountered

from to

<u>Top Soil</u>	<u>0</u>	<u>2</u>
<u>Sandy clay</u>	<u>2</u>	<u>75</u>
<u>Course Sand</u>	<u>75</u>	<u>100</u>
<u>Clay</u>	<u>100</u>	<u>108</u>
<u>Course Sand</u>	<u>108</u>	<u>123</u>


DEPT. OF NATURAL RESOURCES
 BUREAU OF LAND & WATER RESOURCES

DEC 10 1979

RECEIVED

If well telescopes please sketch and show depths.

GROUND LEVEL

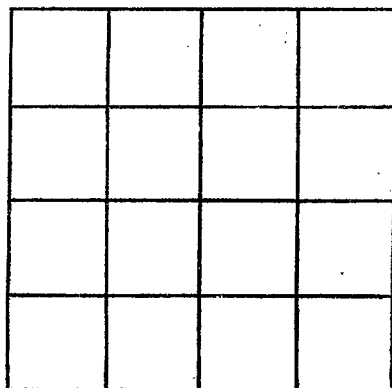

SECTION _____

Please indicate well location X.

ADDITIONAL INFORMATION

If more than one screen, show locations of each on sketch.