

Stone  
 G 2052  
 2-5-80

MISSISSIPPI  
 BOARD OF WATER COMMISSIONERS  
 416 North State Street  
 Jackson, Mississippi 39201

WATER WELL DRILLERS LOG

2-5-80 date well completed  
 80 Jamell Anderson Stone firm name  
 Stone county well located

LANDOWNER:	description of formations encountered	from	to
R. D. Hall	Top Soil	0	2
(mailing address)	Red Clay	2	30
WELL LOCATION:	Flint Sand	30	130
sec. 6 T. 3 N R. 11 E 1 1/2 miles S of W. Bogalusa (distance) (direction) (nearest town)	Course Sand	80	105
WELL PURPOSE: HOME (home, irrigation, municipal, industrial)			
WELL COMPLETION DATA:			
(1) diameter (inches) 2 1/2			
(2) total depth (feet) 105			
(3) static water level (feet) 78' below top of ground.			
(4) casing Plastic 100' (material) (depth)			
(size) if telescope see back.			
(5) screen 5' 100' (length) (depth to top)			
2" Plastic (size) (material)			
(6) pump 1 10 (HP) (yield gpm)			
Elect (type power)			
(7) electric log No (yes or no)			
(organization running log)			
(8) how well bottom plugged capped			
DRILLERS REMARKS:			


DEPT. OF NATURAL RESOURCES  
 BUREAU OF LAND & WATER RESOURCES

MAR 10 1980

RECEIVED

If well telescopes please sketch and show depths.

GROUND LEVEL

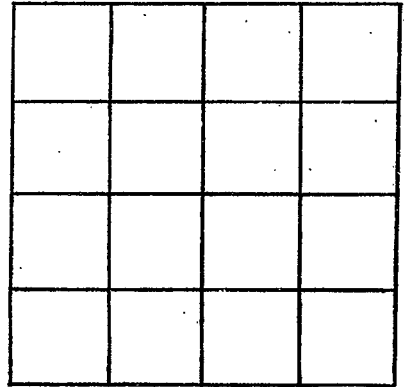

SECTION \_\_\_\_\_

Please indicate well location X.

ADDITIONAL INFORMATION

A series of horizontal lines for recording additional information.

If more than one screen, show locations of each on sketch.