

Stone
 G 2053
 2-27-80

MISSISSIPPI
 BOARD OF WATER COMMISSIONERS
 416 North State Street
 Jackson, Mississippi 39201

WATER WELL DRILLERS LOG

2-27 1980 Parnell Anderson Stone
 date well completed firm name county well located

LANDOWNER:	description of formations encountered	from	to
John Altman			
(mailing address)	Clay	2	10
WELL LOCATION:	Coarse Sand	10	61
sec. 18 T. 3 N. R. 11 E. $\frac{1}{2}$ miles S E of Perk (distance) (direction) (nearest town)			
WELL PURPOSE: HOME (home, irrigation, municipal, industrial)			
WELL COMPLETION DATA:			
(1) diameter (inches) 2"			
(2) total depth (feet) 61'			
(3) static water level (feet) 18' below top of ground.			
(4) casing Plastic 56' (material) (depth)			
(size) If telescope see back.			
(5) screen 5' 5-6' (length) (depth to top)			
2" Plastic (size) (material)			
(6) pump $\frac{1}{2}$ 6 (HP) (yield gpm)			
Elect (type power)			
(7) electric log No (yes or no)			
(organization running log)			
(8) how well bottom plugged Capped			
DRILLERS REMARKS:			


DEPT. OF NATURAL RESOURCES
 BUREAU OF LAND & WATER RESOURCES

MAR 10 1980

RECEIVED

If well telescopes please sketch and show depths.

GROUND LEVEL

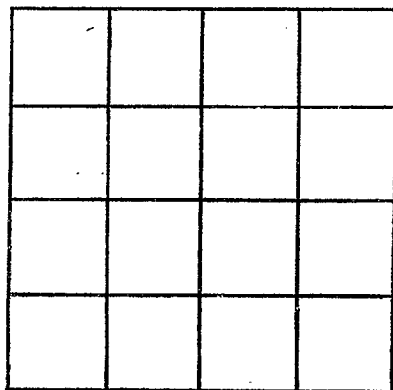

SECTION _____

Please indicate well location X.

ADDITIONAL INFORMATION

If more than one screen,
show locations of each on sketch.