

Stone
G 2034
5-5-80

MISSISSIPPI
BOARD OF WATER COMMISSIONERS
416 North State Street
Jackson, Mississippi 39201

WATER WELL DRILLERS LOG

5-5-80 date well completed 1980 Parnell Anderson firm name Stone county well located


LANDOWNER:	description of formations encountered	from	to
Cover Cain			
(mailing address)	Red Clay	2	18
WELL LOCATION:	Course Sand	18	97
sec. <u>3</u> T. <u>3</u> N. R. <u>11</u> E. S. <u>5</u> W.			
<u>5</u> miles <u>SE</u> of <u>Wiggins</u>			
(distance) (direction) (nearest town)			
WELL PURPOSE: <u>HOME</u>			
(home, irrigation, municipal, industrial)			
WELL COMPLETION DATA:			
(1) diameter (inches) <u>2"</u>			
(2) total depth (feet) <u>97'</u>			
(3) static water level (feet) <u>40</u> below top of ground.			
(4) casing <u>Plastic</u> , <u>92'</u> (material) (depth)			
(size) if telescope see back.			
(5) screen <u>5"</u> <u>92'</u> (length) (depth to top)			
<u>2"</u> <u>Plastic</u> (size) (material)			
(6) pump <u>1</u> <u>10</u> (HP) (yield gpm)			
<u>Elect</u> (type power)			
(7) electric log <u>None</u> (yes or no)			
(organization running log)			
(8) how well bottom plugged <u>covered</u>			
DRILLERS REMARKS:			

DEPT. OF NATURAL RESOURCES
BUREAU OF LAND & WATER RESOURCES

JUN 4 - 1980
RECEIVED

If well telescopes please sketch and show depths.

GROUND LEVEL

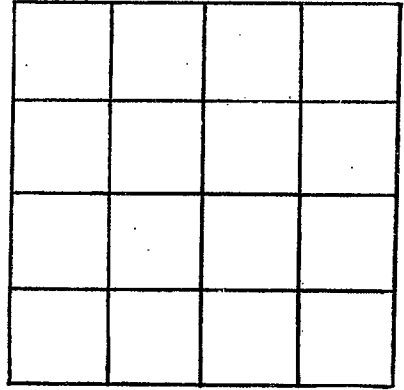

SECTION _____

Please indicate well location X.

ADDITIONAL INFORMATION

If more than one screen,
show locations of each on sketch.