

STONE

MISSISSIPPI  
BOARD OF WATER COMMISSIONERS 2  
416 North State Street  
Jackson, Mississippi 39201

B 2055  
7/21/80

WATER WELL DRILLERS LOG

7-21 1980 Arnell Anderson Stone  
date well completed firm name county well located

LANDOWNER: Jerry Parsons  
description of formations encountered from to  
Top Soil 0 2  
Clay 2 45  
(mailing address)

WELL LOCATION:  
sec. 6 T 3 N R 11 W  
S W  
1 1/2 miles S of Yazoo  
(distance) (direction) (nearest town)

WELL PURPOSE: HOME  
(home, irrigation, municipal, industrial)


WELL COMPLETION DATA:  
(1) diameter (inches) 2"  
(2) total depth (feet) 77'  
(3) static water level (feet) 32' below above top of ground.  
(4) casing Plastic, 92'  
(material) (depth)  
\_\_\_\_\_ if telescope see back.  
(size)  
(5) screen 15', 92'  
(length) (depth to top)  
2", Plastic  
(size) (material)  
(6) pump 1, 8  
(HP) (yield gpm)  
Elect  
(type power)  
(7) electric log no  
(yes or no)  
\_\_\_\_\_  
(organization running log)  
(8) how well bottom plugged  
Capped

DEPT. OF NATURAL RESOURCES  
BUREAU OF LAND & WATER RESOURCES  
AUG 8 1980  
RECEIVED

DRILLERS REMARKS:  
\_\_\_\_\_  
\_\_\_\_\_

If well telescopes please sketch and show depths.

GROUND LEVEL

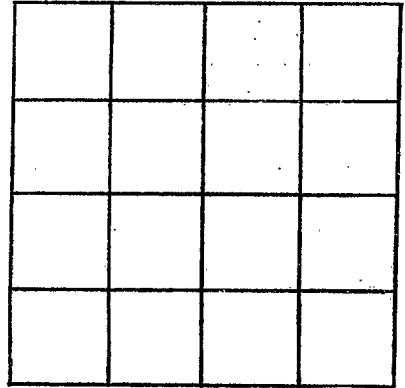

SECTION \_\_\_\_\_

Please indicate well location X.

ADDITIONAL INFORMATION

If more than one screen,  
show locations of each on sketch.