

STONE  
 B-2057  
 9-2-80

MISSISSIPPI  
 BOARD OF WATER COMMISSIONERS  
 416 North State Street  
 Jackson, Mississippi 39201

WATER WELL DRILLERS LOG

9-2 1980 Karnell Anderson Stone  
 date well completed firm name county well located

LANDOWNER: Jerry Hughes  
At 2  
Wiggins, MS  
 (mailing address)  
 WELL LOCATION:  
 sec. 6 T. 3 N. R. 11 E. S. 5 W.  
3 miles S of Wiggins  
 (distance) (direction) (nearest town)

description of formations encountered	from	to
<u>Top soil</u>	<u>0</u>	<u>3</u>
<u>Clay</u>	<u>3</u>	<u>14</u>
<u>Fine sand</u>	<u>14</u>	<u>28</u>
<u>Clay</u>	<u>28</u>	<u>80</u>
<u>Coarse Sand</u>	<u>80</u>	<u>105</u>

WELL PURPOSE: Home  
 (home, irrigation, municipal, industrial)

WELL COMPLETION DATA:  
 (1) diameter (inches) 2"  
 (2) total depth (feet) 105'  
 (3) static water level (feet) 60 below top of ground.  
 (4) casing Plastic, 100'  
 (material) (depth)  
 (size) If telescope see back.  
 (5) screen 5', 60'  
 (length) (depth to top)  
 (size) (material)  
 (6) pump 1, 0  
 (HP) (yield gpm)  
Electric  
 (type power)  
 (7) electric log NO  
 (yes or no)  
 (organization running log)  
 (8) how well bottom plugged Capped

DEPT. OF NATURAL RESOURCES  
 BUREAU OF LAND & WATER RESOURCES


OCT 14 1980

RECEIVED

DRILLERS REMARKS:  
 \_\_\_\_\_  
 \_\_\_\_\_  
 \_\_\_\_\_

If well telescopes please  
sketch and show depths.

GROUND LEVEL

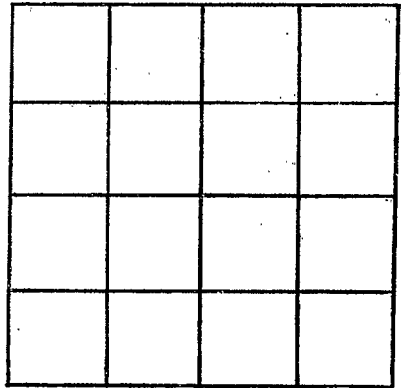

SECTION \_\_\_\_\_

Please indicate well location X.

ADDITIONAL INFORMATION

If more than one screen,  
show locations of each on sketch.