

STONE
G 2058

MISSISSIPPI
 BOARD OF WATER COMMISSIONERS
 416 North State Street
 Jackson, Mississippi 39201

WATER WELL DRILLERS LOG

10-15-80
10-15-80 1980

Bornwell Andersen Stone
 firm name county well located

LANDOWNER: Alvin Kesley
Rt 2
Perkinston
 (mailing address)

WELL LOCATION:
 sec. 1 T. 3 R. 11
 S W
11 miles E of Wiggins
 (distance) (direction) (nearest town)

WELL PURPOSE: home
 (home, irrigation, municipal, industrial)

- WELL COMPLETION DATA:
- (1) diameter (inches) 2"
 - (2) total depth (feet) 116
 - (3) static water level (feet) 45' below top of ground.
 - (4) casing 2" Plastic
 (material) (depth)
 - 2" if telescope see back.
 (size)
 - (5) screen 5' 111'
 (length) (depth to top)
 - 2" Plastic
 (size) (material)
 - (6) pump 1 12
 (HP) (yield gpm)
 - Submersible
 (type power)
 - (7) electric log NO
 (yes or no)
 - (organization running log)
 - (8) how well bottom plugged Capped

description of formations encountered	from	to
<u>Top Soil</u>	<u>0</u>	<u>2</u>
<u>Clay</u>	<u>2</u>	<u>18</u>
<u>Sand</u>	<u>18</u>	<u>38</u>
<u>Clay</u>	<u>38</u>	<u>80</u>
<u>Fine Sand</u>	<u>80</u>	<u>96</u>
<u>Coarse Sand</u>	<u>96</u>	<u>116</u>

DRILLERS REMARKS:


DEPT. OF NATURAL RESOURCES
 BUREAU OF LAND & WATER RESOURCES

JAN 12 1981

RECEIVED

If well telescopes please
sketch and show depths.

GROUND LEVEL

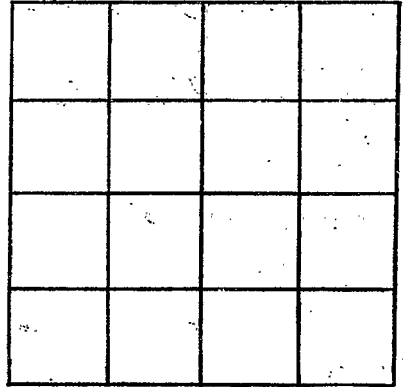

SECTION _____

Please indicate well location X.

ADDITIONAL INFORMATION

If more than one screen,
show locations of each on sketch.