

STONE  
 6 205  
 11-21-80  
 11-21-

MISSISSIPPI  
 BOARD OF WATER COMMISSIONERS  
 416 North State Street  
 Jackson, Mississippi 39201

WATER WELL DRILLERS LOG

date well completed

firm name

county well located

1980 Turner Andersen Stone

LANDOWNER: William C Cooper

description of formations encountered

from to

Qtz  
Perkinston, Ms 39573  
 (mailing address)

|                  |           |           |
|------------------|-----------|-----------|
| <u>Top soil</u>  | <u>0</u>  | <u>3</u>  |
| <u>clay</u>      | <u>3</u>  | <u>24</u> |
| <u>Fine Sand</u> | <u>24</u> | <u>30</u> |
| <u>clay</u>      | <u>30</u> | <u>52</u> |
| <u>Sand</u>      | <u>52</u> | <u>80</u> |

WELL LOCATION:

sec. 9 T. 3 S. R. 11 W.  
6 miles E of Wiggins  
 (distance) (direction) (nearest town)

WELL PURPOSE:

(home, irrigation, municipal, industrial)

WELL COMPLETION DATA:

- (1) diameter (inches) 2"
- (2) total depth (feet) 80'
- (3) static water level (feet) 25' below top of ground.
- (4) casing Plastic, 75' (material) (depth)  
2" (size) if telescope see back.
- (5) screen 5', 75' (length) (depth to top)  
2" (size) Plastic (material)
- (6) pump 1 (HP) 8 (yield gpm)  
Electric (type power)
- (7) electric log NO (yes or no)

(organization running log)

(8) how well bottom plugged rapped

DRILLERS REMARKS:


DEPT. OF NATURAL RESOURCES  
 BUREAU OF LAND & WATER RESOURCES

JAN 12 1991

RECEIVED

If well telescopes please sketch and show depths.

GROUND LEVEL

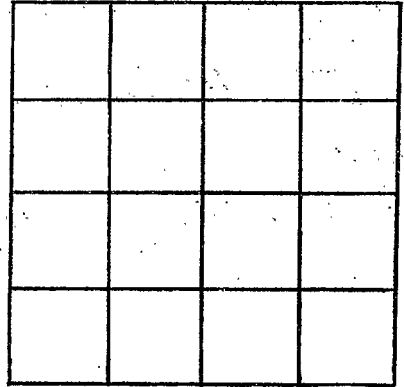

SECTION \_\_\_\_\_

Please indicate well location X.

ADDITIONAL INFORMATION

If more than one screen,  
show locations of each on sketch.