

STONE

G 2060

12-19-80

12-19

date well completed

MISSISSIPPI BOARD OF WATER COMMISSIONERS 416 North State Street Jackson, Mississippi 39201

WATER WELL DRILLERS LOG

19 80 F. P. Farnell Anderson Stone firm name county well located

LANDOWNER: Gene Cain

P.O. Box 717

Wiggins, MS 39577 (mailing address)

WELL LOCATION:

sec. 8 T. 3 R. 11 S. 4 miles NE of Wiggins (distance) (direction) (nearest town)

WELL PURPOSE: home (home, irrigation, municipal, industrial)

WELL COMPLETION DATA:

- (1) diameter (inches) 2"
(2) total depth (feet) 65'
(3) static water level (feet) 30' below top of ground.
(4) casing Plastic 60' (material) (depth) 2" (size) if telescope see back.
(5) screen 5' 60' (length) (depth to top) 2" Plastic (size) (material)
(6) pump 1 13 (HP) (yield gpm) Electric (type power)
(7) electric log NO (yes or no)

(organization running log)

(8) how well bottom plugged Capped

DRILLERS REMARKS:

description of formations encountered

from to

Table with 3 columns: description of formations encountered, from, to. Rows include: Top soil (0-2), Clay (2-18), Fine sand (18-30), Clay (30-42), Coarse sand (42-65)


DEPT. OF NATURAL RESOURCES BUREAU OF LAND & WATER RESOURCES

JAN 12 1981

RECEIVED

If well telescopes please sketch and show depths.

GROUND LEVEL

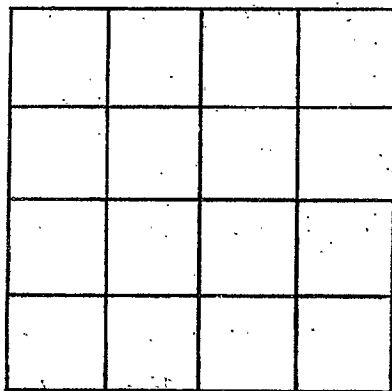

SECTION \_\_\_\_\_

Please indicate well location X.

ADDITIONAL INFORMATION

If more than one screen, show locations of each on sketch.