

MISSISSIPPI DEPARTMENT OF NATURAL RESOURCES

Bureau of Land and Water Resources

Southport Mall

P.O. Box 10631

Jackson, Mississippi 39209

WATER WELL DRILLERS LOG

STONE  
 52061  
 1/21/81  
 Jan 21 1981

date well completed 1981 firm name Farmer Anderson county well located Stone

LANDOWNER: Franklin Hunt  
Rt 1  
Wiggins  
 (mailing address)

description of formations encountered	from	to
<u>Top soil</u>	<u>0</u>	<u>2</u>
<u>clay</u>	<u>2</u>	<u>22</u>
<u>fine sand</u>	<u>22</u>	<u>38</u>
<u>clay</u>	<u>38</u>	<u>56</u>
<u>Sand</u>	<u>56</u>	<u>85</u>

WELL LOCATION:  
 sec. 3 T. 3 N. R. 11 E.  
4 miles E of Wiggins  
 (distance) (direction) (nearest town)

WELL PURPOSE: home  
 (home, irrigation, municipal, industrial)

- WELL COMPLETION DATA:
- (1) diameter (inches) 2"
  - (2) total depth (feet) 85'
  - (3) static water level (feet) 40 below above top of ground.
  - (4) casing PVC, 80  
 (material) (depth)  
 (size) if telescope see back.
  - (5) screen 5', 80  
 (length) (depth to top)  
2", PVC  
 (size) (material)
  - (6) pump 1, 11  
 (HP) (yield gpm)  
Electric  
 (type power)
  - (7) electric log NO  
 (yes or no)  
 (organization running log)
  - (8) how well bottom plugged Yes

DRILLERS REMARKS:


DEPT. OF NATURAL RESOURCES  
 BUREAU OF LAND & WATER RESOURCES

MAY 18 1981

RECEIVED

If well telescopes please sketch and show depths.

GROUND LEVEL

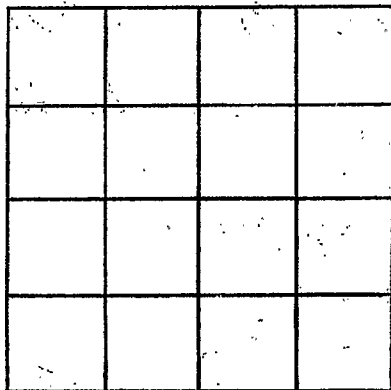

SECTION \_\_\_\_\_

Please indicate well location X.

ADDITIONAL INFORMATION

If more than one screen,  
show locations of each on sketch.