

MISSISSIPPI DEPARTMENT OF NATURAL RESOURCES

Bureau of Land and Water Resources

Southport Mall

P.O. Box 10631

Jackson, Mississippi 39209

WATER WELL DRILLERS LOG

STONE
 52002
 4-17-81
 April

72
 1/1
 6

17 1981 J.S. Well Co Stone
 date well completed firm name county well located

LANDOWNER: CARMAN
 ONEAL # 3 Box 292
 Peck, Miss. 393
 (mailing address)

description of formations encountered	from	to
top soil clay	0	10
Clay yellow grey	10	20
DARK Grey clay	20	30
Dark clay shale	30	40
lime sand	40	50
Course sand	50	60
Course sand pea	60	70
gravel	70	72

WELL LOCATION:
 sec 13 T 3 N R 11 E W
 Wiggins 5 SE of Wiggins
 (distance) miles (direction) of (nearest town)

WELL PURPOSE:
 (home, irrigation, municipal, industrial)

- WELL COMPLETION DATA:
- (1) diameter (inches) 2
 - (2) total depth (feet) 72
 - (3) static water level (feet) 1-2ft below above top of ground.
 - (4) casing plastic 67 (material) (depth)
 - (5) screen 5' 67 (length) (depth to top)
 - (6) pump 2 plastic (size) (material)
 - (7) pump 1 12 gpm (HP) (yield gpm)
 - (8) electric log (yes or no)
- (organization running log)
 Plastic Cap


DRILLERS REMARKS:

DEPT. OF NATURAL RESOURCES
 BUREAU OF LAND & WATER RESOURCES

JUN 2 1981
 RECEIVED

If well telescopes please sketch and show depths.

GROUND LEVEL

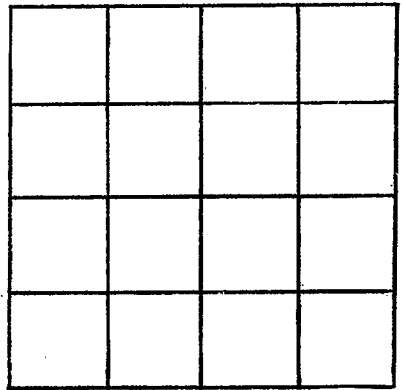

SECTION _____

Please indicate well location X.

ADDITIONAL INFORMATION

If more than one screen, show locations of each on sketch.