

MISSISSIPPI DEPARTMENT OF NATURAL RESOURCES
Bureau of Land and Water Resources
 Southport Mall
 P.O. Box 10631
 Jackson, Mississippi 39209
WATER WELL DRILLERS LOG

STONE
5 2003
6-24-81

JUNE 24 1981 J&B WELL STONE
 date well completed firm name county well located

LANDOWNER: Ronnie Sims
GEN DELIVERY
PERKINSTON MS.
 (mailing address)
 WELL LOCATION: NW 1/4
 sec. 19 T. 3 N. R. 11 E.
3/4 mile SE of PERKINSTON
 (distance) (direction) (nearest town)

description of formations encountered	from	to
RED CLAY	0	10
YELLOW SHAPE CLAY	10	20
" "	20	30
" "	30	40
BLUE CLAY	40	50
" "	50	60
" "	60	70
FINE SAND	70	80
" "	80	90
MED FINE "	90	100
COARSE "	100	110
COARSE "	110	120

WELL PURPOSE: HOME
 - (home, irrigation, municipal, industrial)


- WELL COMPLETION DATA:
- diameter (inches) 2
 - total depth (feet) 122
 - static water level (feet) 56 below top of ground.
 - casing 2 112
 (material) (depth)
4 if telescope see back.
 (size)
 - screen 112 112
 (length) (depth to top)
2 PLASTIC
 (size) (material)
 - pump 1 65
 (HP) (yield gpm)
ELC
 (type power)
 - electric log yes or no
 (organization running log)
 - how well bottom plugged PLASTIC CAP

DEPT. OF NATURAL RESOURCES
 BUREAU OF LAND & WATER RESOURCES
 JUN 29 1981
RECEIVED

DRILLERS REMARKS:

If well telescopes please
sketch and show depths.

GROUND LEVEL

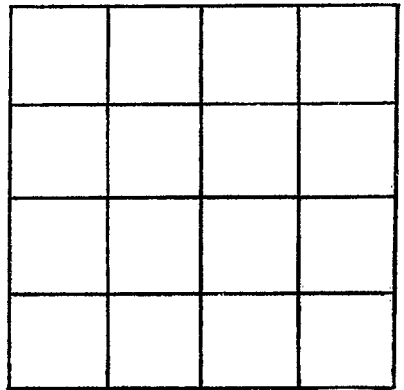

SECTION _____

Please indicate well location X.

ADDITIONAL INFORMATION

If more than one screen,
show locations of each on sketch.