

MISSISSIPPI DEPARTMENT OF NATURAL RESOURCES

Bureau of Land and Water Resources

Southport Mall

P.O. Box 10631

Jackson, Mississippi 39209

WATER WELL DRILLERS LOG

Stone
G 2004
8-31-81

9-31

1981

Parnee Anderson Stone

date well completed

firm name

county well located

LANDOWNER: J.A. Rayner

Rt 4

Perkinston, Ms
(mailing address)

description of formations encountered

Top Soil
Clay
Sand
Clay
Sand

from

to

0	3
3	16
16	44
44	60
60	85

WELL LOCATION:

sec. 14 T. 3 N. R. 11 E.
4 1/2 miles E of Perkinston
(distance) (direction) (nearest town)

WELL PURPOSE: Home
(home, irrigation, municipal, industrial)

WELL COMPLETION DATA:

- (1) diameter (inches) 2"
- (2) total depth (feet) 85'
- (3) static water level (feet) 20 below above top of ground.
- (4) casing PVC, 80',
(material) (depth)
(size) if telescope see back.
- (5) screen 5', 80'
(length) (depth to top)
(size) PVC
(material)
- (6) pump 1 (HP), 11 (yield gpm)
Electric
(type power)
- (7) electric log NO
(yes or no)

(organization running log)

(8) how well bottom plugged Capped

DRILLERS REMARKS:


DEPT. OF NATURAL RESOURCES
BUREAU OF LAND & WATER RESOURCES

OCT 2 1981

RECEIVED

If well telescopes please sketch and show depths.

GROUND LEVEL

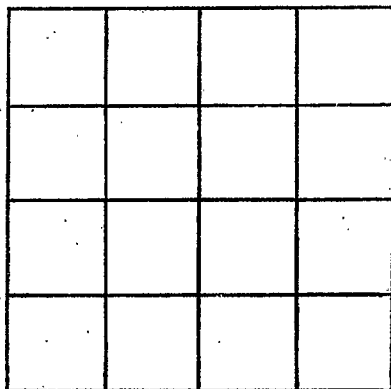

SECTION _____

Please indicate well location X.

ADDITIONAL INFORMATION

If more than one screen,
show locations of each on sketch.