

MISSISSIPPI DEPARTMENT OF NATURAL RESOURCES

Bureau of Land and Water Resources

Southport Mall

P.O. Box 10631

Jackson, Mississippi 39209

WATER WELL DRILLERS LOG

Stone
G 2005
9-2-81

9-2 1981 Parnell Anderson Stone
 date well completed firm name county well located

LANDOWNER: Ben A. Hunt
Rt 1
Wiggins, MS
 (mailing address)

description of formations encountered	from	to
<u>Top soil</u>	<u>0</u>	<u>3</u>
<u>Clay</u>	<u>3</u>	<u>19</u>
<u>Sand</u>	<u>19</u>	<u>38</u>
<u>Clay</u>	<u>38</u>	<u>50</u>
<u>Sand</u>	<u>50</u>	<u>64</u>

WELL LOCATION:
 sec. 3 T. 3 S. R. 11 E.
53+ miles SE of Wiggins
 (distance) (direction) (nearest town)

WELL PURPOSE: Home
 (home, irrigation, municipal, industrial)

WELL COMPLETION DATA:

(1) diameter (inches) 2"

(2) total depth (feet) 64'

(3) static water level (feet) 30' below above top of ground.

(4) casing PVC, 59'
 (material) (depth)
 (size) if telescope see back.

(5) screen 5', 59'
 (length) (depth to top)
2", PVC
 (size) (material)

(6) pump 1 11
 (HP) (yield gpm)
Electric
 (type power)

(7) electric log NO
 (yes or no)

DEPT. OF NATURAL RESOURCES
 BUREAU OF LAND & WATER RESOURCES

OCT - 2 1981

RECEIVED


(organization running log)

(8) how well bottom plugged Capped

DRILLERS REMARKS:

If well telescopes please sketch and show depths.

GROUND LEVEL

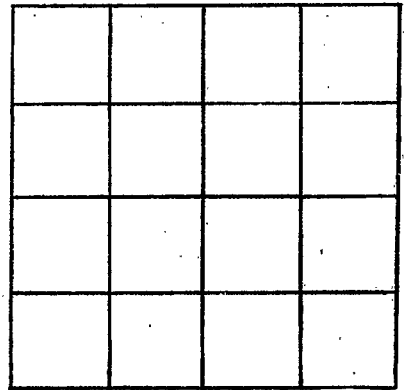

SECTION _____

Please indicate well location X.

ADDITIONAL INFORMATION

If more than one screen,
show locations of each on sketch.