

MISSISSIPPI DEPARTMENT OF NATURAL RESOURCES

Bureau of Land and Water Resources

Southport Mall

P.O. Box 10631

Jackson, Mississippi 39209

WATER WELL DRILLERS LOG

Stone
50067
12/15/81

12-15 1981
 date well completed

Frank Price
 firm name

Stone
 county well located

LANDOWNER:
J. L. Price
 (mailing address)

description of formations encountered	from	to
<u>Top Soil</u>	<u>0</u>	<u>3</u>
<u>Red clay</u>	<u>3</u>	<u>15</u>
<u>Coarse Sand</u>	<u>15</u>	<u>50</u>

WELL LOCATION:
 sec. 9 T. 3 S. R. 11 E.
3 1/2 miles W of Big Level
 (distance) (direction) (nearest town)

WELL PURPOSE: HOME
 (home, irrigation, municipal, industrial)

WELL COMPLETION DATA:

(1) diameter (inches) 2"

(2) total depth (feet) 50

(3) static water level (feet) 16' below top of ground.

(4) casing Plastic, 45'
 (material) (depth)

(size) if telescope see back.

(5) screen 3', 45'
 (length) (depth to top)

2", Plastic
 (size) (material)

(6) pump 1/2, 6
 (HP) (yield gpm)

Elect
 (type power)

(7) electric log no
 (yes or no)

(organization running log)

(8) how well bottom plugged Back wash water

DRILLERS REMARKS:


DEPT. OF NATURAL RESOURCES
 BUREAU OF LAND & WATER RESOURCES

JAN 5 - 1982

RECEIVED

If well telescopes please sketch and show depths.

GROUND LEVEL

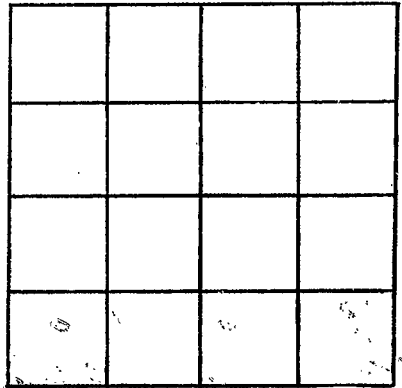

SECTION _____

Please indicate well location X.

ADDITIONAL INFORMATION

If more than one screen, show locations of each on sketch.